

Marshall
 L 11
 6-1-68

MISSISSIPPI
 BOARD OF WATER COMMISSIONERS
 416 North State Street
 Jackson, Mississippi 39201

CODED

WATER WELL DRILLERS LOG

June 1 19 68 R. L. Carpenter Marshall
 date well completed firm name county well located

LANDOWNER:

Marshall County
 Holly Springs
 Experiment Station
 (mailing address)

description of formations encountered

from to

Surface soil	0	14
Med-red Sand	14	45
White Clay	45	47
Med-White sand	47	72
White clay	72	77
Med. White sand	77	100
White Clay	100	104
White Coarse sand	104	120
Med. White Sand & White Clay	120	126
Blue mud	126	133
White Co	133	170

WELL LOCATION:

sec. 17 T. 3 N. R. 2 E
 3 miles North of Holly Springs
 (distance) (direction) (nearest town)


WELL PURPOSE:

Farm -
 (home, irrigation, municipal, industrial)

WELL COMPLETION DATA:

- (1) diameter (inches) 4
- (2) total depth (feet) 170 ft
- (3) static water level (feet) 80 below top of ground.
- (4) casing Plastic, 158 ft
 (material) (depth)
- (size) if telescope see back.
- (5) screen 12 ft, 158 ft
 (length) (depth to top)
 4" Plastic + gravel
 (size) (material)
- (6) pump 3/4 12
 (HP) (yield gpm)
 elec -
 (type power)
- (7) electric log no
 (yes or no)
- (organization running log)
- (8) how well bottom plugged Plastic Plug

CODED

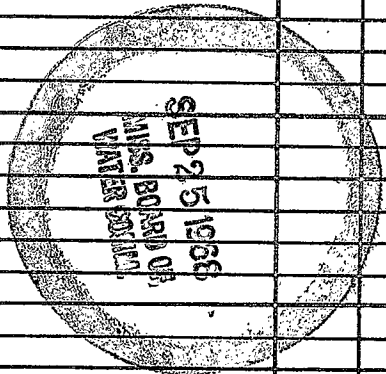

DRILLERS REMARKS:

If well telescopes please sketch and show depths.

GROUND LEVEL

R 2 W

T 35

	*		

SECTION 17

Please indicate well location X.

ADDITIONAL INFORMATION

If more than one screen, show locations of each on sketch.