

Marshall  
 L 13  
 8-68

MISSISSIPPI  
 BOARD OF WATER COMMISSIONERS  
 416 North State Street  
 Jackson, Mississippi 39201

WATER WELL DRILLERS LOG **CODED**

Aug 16 1968 Bonpas Well Co. Marshall  
 date well completed firm name county well located

LANDOWNER: James Smith

description of formations encountered	from	to
<del>#1</del> Clay	0	140
San J #40	140	240


#1  
Holly Springs Miss.  
 (mailing address)

WELL LOCATION:  
 sec. 18 T. 3 N. R. 2 E.  
4 miles E of Holly Springs  
 (distance) (direction) (nearest town)

WELL PURPOSE:  
 (home, irrigation, municipal, industrial)

- WELL COMPLETION DATA:
- (1) diameter (inches) 4"
  - (2) total depth (feet) 240
  - (3) static water level (feet) 180 below above top of ground.
  - (4) casing 4" plate, 9-33  
 (material) (depth)  
4" if telescope see back.  
 (size)
  - (5) screen 2 1/2", 233  
 (length) (depth to top)  
4" Gravel Wall  
 (size) (material)
  - (6) pump 3/4 10  
 (HP) (yield gpm)  
Elect.  
 (type power)
  - (7) electric log \_\_\_\_\_  
 (yes or no)  
 \_\_\_\_\_  
 (organization running log)
  - (8) how well bottom plugged 4" plug

**CODED**

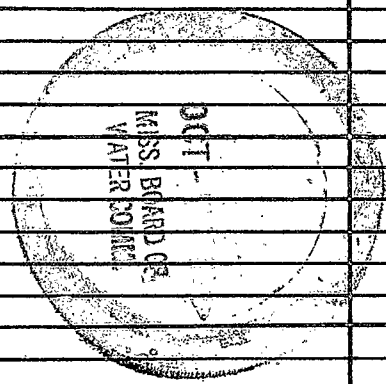

DRILLERS REMARKS:

If well telescopes please sketch and show depths.

GROUND LEVEL


SECTION \_\_\_\_\_

Please indicate well location X.

ADDITIONAL INFORMATION

If more than one screen,  
show locations of each on sketch.