

MARSHALL
L 14
9-14-71

MISSISSIPPI
BOARD OF WATER COMMISSIONERS
416 North State Street
Jackson, Mississippi 39201
WATER WELL DRILLERS LOG

CODED

9-14-1971
date well completed

Bob Smith
firm name

Marshall
county well located

LANDOWNER:

Marshall Debuschmit

Holly Springs, Miss.
(mailing address)

description of formations encountered

from

to

<u>top soil</u>	<u>0</u>	<u>5</u>
<u>red clay</u>	<u>5</u>	<u>20</u>
<u>red sand</u>	<u>20</u>	<u>40</u>
<u>subsit. sand</u>	<u>40</u>	<u>260</u>

WELL LOCATION:

sec. 26 T 3 N R. 2 E
(S) (W)
2 miles east of Holly Springs
(distance) (direction) (nearest town)

WELL PURPOSE:

(home, irrigation, municipal, industrial)

WELL COMPLETION DATA:

- (1) diameter (inches) 4
- (2) total depth (feet) 260
- (3) static water level (feet) 210 below top of ground.
- (4) casing Plastic, 260
(material) (depth)
(size) if telescope see back.
- (5) screen 20, 240
(length) (depth to top)
4, Plastic
(size) (material)
- (6) pump 3/4, 15
(HP) (yield gpm)
Elco
(type power)
- (7) electric log no
(yes or no)

(organization running log)

- (8) how well bottom plugged plugged

DRILLERS REMARKS:


CODED

NOV 22 1971

MISS. BD. OF
WATER COMMISSIONERS

If well telescopes please sketch and show depths.

GROUND LEVEL

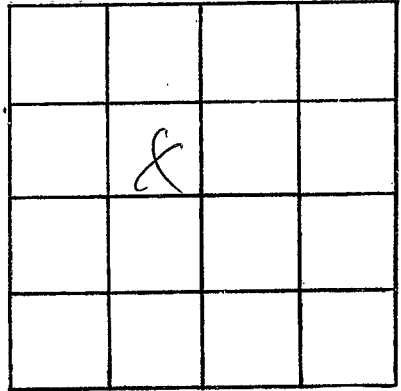

SECTION _____

Please indicate well location X.

ADDITIONAL INFORMATION

If more than one screen, show locations of each on sketch.