

MARSHALL
L 16
4-7-72

MISSISSIPPI
 BOARD OF WATER COMMISSIONERS
 416 North State Street
 Jackson, Mississippi 39201

WATER WELL DRILLERS LOG

CODED

4-7 1972 P. & H Well Co. MARSHALL
 date well completed firm name county well located

LANDOWNER: MARTIN - VANZANT

description of formations encountered

from

to

HOLLY SPRINGS

<u>Red SAND</u>	<u>0</u>	<u>4.5</u>
<u>Redish White SAND</u>	<u>4.5</u>	<u>7.5</u>
<u>White SAND</u>	<u>7.5</u>	<u>14.5</u>

MISS

(mailing address)

WELL LOCATION:

sec. 35 T 3 N R 2 E
 8 miles NW of HOLLY SPRING
 (distance) (direction) (nearest town)

WELL PURPOSE:

(home, irrigation, municipal, industrial)

WELL COMPLETION DATA:

- (1) diameter (inches) 4"
- (2) total depth (feet) 14.5
- (3) static water level (feet) 84' below top of ground.
- (4) casing PLASTIC, 1.35
 (material) (depth)

_____ if telescope see back.
 (size)

- (5) screen 10', 1.35'
 (length) (depth to top)
- 4", PLASTIC
 (size) (material)

- (6) pump 3/4, 10 GPM
 (HP) (yield gpm)
- 220 ELEC
 (type power)

- (7) electric log NO
 (yes or no)

_____ (organization running log)

- (8) how well bottom plugged CAP

CODED


MAY 1 1972

DRILLERS REMARKS:

MISS. BD. OF
 WATER CONTROL

If well telescopes please sketch and show depths.

GROUND LEVEL

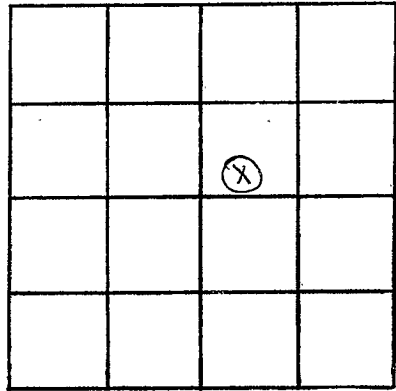

SECTION _____

Please indicate well location X.

ADDITIONAL INFORMATION

A series of horizontal lines for writing additional information.

If more than one screen, show locations of each on sketch.