

MARSHALL
L 19
11-15-71

MISSISSIPPI
 BOARD OF WATER COMMISSIONERS
 416 North State Street
 Jackson, Mississippi 39201

WATER WELL DRILLERS LOG

CODED

Nov. 15 1971 R. L. Carpenter Marshall
 date well completed firm name county well located

LANDOWNER: R. L. Mitchell
Holly Springs
Mrs. RFD
 (mailing address)

WELL LOCATION:
 sec 16 T 3 N R 1 E
6 miles northeast of Holly Springs
 (distance) (direction) (nearest town)

WELL PURPOSE: Home
 (home, irrigation, municipal, industrial)

- WELL COMPLETION DATA:
- (1) diameter (inches) 4
 - (2) total depth (feet) 253
 - (3) static water level (feet) 183 below top of ground.
 - (4) casing Plastic 247 ft.
 (material) (depth)
 - (size) if telescope see back.
 - (5) screen 6 ft 247 ft
 (length) (depth to top)
 - 4 in Plastic & Gravel
 (size) (material)
 - (6) pump 1 15
 (HP) (yield gpm)
 - Elec.
 (type power)
 - (7) electric log no
 (yes or no)
 - (organization running log)
 - (8) how well bottom plugged Plastic Cap

description of formations encountered	from	to
<u>Surface Soil</u>	<u>0</u>	<u>19</u>
<u>med white sand</u>	<u>19</u>	<u>120</u>
<u>white clay</u>	<u>120</u>	<u>138</u>
<u>med white sand</u>	<u>138</u>	<u>219</u>
<u>white coarse sand</u>	<u>219</u>	<u>253</u>

CODED


AUG - 4 1972

DRILLERS REMARKS:

MISS. DIV. OF
 WATER RESOURCES

If well telescopes please sketch and show depths.

GROUND LEVEL

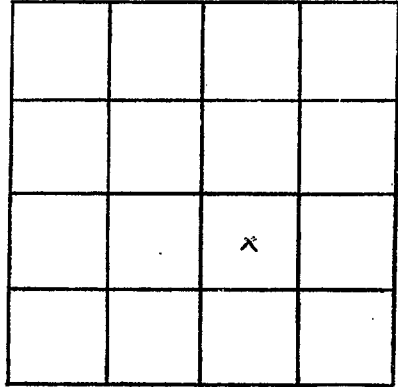

SECTION 16

Please indicate well location X.

ADDITIONAL INFORMATION

A series of horizontal lines for writing additional information, starting below the 'ADDITIONAL INFORMATION' header and extending down to the bottom of the page.

If more than one screen, show locations of each on sketch.