

MARSHALL
L 20
11-30-72

MISSISSIPPI
 BOARD OF WATER COMMISSIONERS
 416 North State Street
 Jackson, Mississippi 39201
WATER WELL DRILLERS LOG

CODED

11-30-72
 date well completed

1972 Dean Kent Burgess
 firm name

Marshall
 county well located

LANDOWNER:
 Robert Boone
 Holly Springs, Miss.
 (mailing address)

description of formations encountered	from	to
	clay	0
sand	50	210

WELL LOCATION:
 sec. 29 T. 3 N. R. 2 E.
 2 miles NORTH of Holly Springs
 (distance) (direction) (nearest town)

WELL PURPOSE: Drilling
 (home, irrigation, municipal, industrial)

- WELL COMPLETION DATA:**
- (1) diameter (inches) 4"
 - (2) total depth (feet) 210 feet
 - (3) static water level (feet) 150' below top of ground.
 - (4) casing PVC, 210 (material), (depth)
 - (size) if telescope see back.
 - (5) screen 74", 203 feet (length), (depth to top)
 - 4" gravel wash (size), (material)
 - (6) pump 3/4 (HP), 14 (yield gpm)
 - (type power)
 - (7) electric log yes (yes or no)
 - (organization running log)
 - (8) how well bottom plugged 4' cof.


CODED

JAN 2 1972

DRILLERS REMARKS:

If well telescopes please sketch and show depths.

GROUND LEVEL

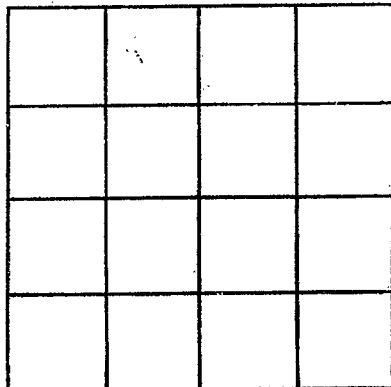

SECTION _____

Please indicate well location X.

ADDITIONAL INFORMATION

If more than one screen,
show locations of each on sketch.