

MARSHALL
L 21
12-11-72

MISSISSIPPI
 BOARD OF WATER COMMISSIONERS
 416 North State Street
 Jackson, Mississippi 39201

CODED

WATER WELL DRILLERS LOG

12-11 1972 Hicks Brothers Marshall
 date well completed firm name county well located

LANDOWNER: <u>FLOYD McCarry</u>	description of formations encountered	from	to
<u>PT. 3 BOX 540</u>			
<u>Holly Springs, Miss</u> (mailing address)	<u>White clay</u>	<u>15</u>	<u>45</u>
	<u>White sandy clay</u>	<u>45</u>	<u>105</u>
	<u>White sand</u>	<u>105</u>	<u>255</u>

WELL LOCATION:
 sec 33 T 3 N R 2 E
2 1/2 miles West of Holly Sp.
 (distance) (direction) (nearest town)

WELL PURPOSE: Home
 (home, irrigation, municipal, industrial)


- WELL COMPLETION DATA:
- diameter (inches) 4"
 - total depth (feet) 255
 - static water level (feet) 182 below above top of ground.
 - casing plastic, 249,
 (material) (depth)
 (size) if telescope see back.
 - screen 6', 6'
 (length) (depth to top)
4", Gravel-plastic
 (size) (material)
 - pump 3/4, 10
 (HP) (yield gpm)
220 F100
 (type power)
 - electric log NO
 (yes or no)
 (organization running log)
 - how well bottom plugged COP

JAN 13 1973

DRILLERS REMARKS:

If well telescopes please sketch and show depths.

GROUND LEVEL

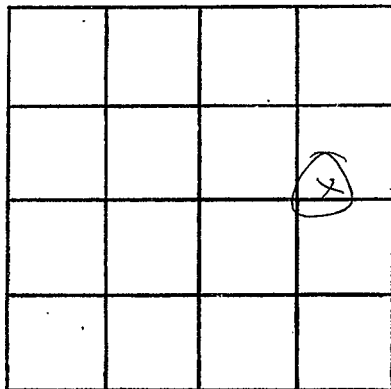

SECTION _____

Please indicate well location X.

ADDITIONAL INFORMATION

If more than one screen,
show locations of each on sketch.