

Marshall  
L 27  
7-29-75

MISSISSIPPI  
BOARD OF WATER COMMISSIONERS  
416 North State Street  
Jackson, Mississippi 39201

WATER WELL DRILLERS LOG

CODED

July 29 1975 Dean Kent Buffet Marshall  
date well completed firm name county well located

LANDOWNER:  
Joseph C. Fenell  
Holly Springs, Miss  
(mailing address)

description of formations encountered	from	to
<u>clay</u>	<u>0</u>	<u>20</u>
<u>sand</u>	<u>20</u>	<u>40</u>
<u>clay</u>	<u>40</u>	<u>45</u>
<u>sand</u>	<u>45</u>	<u>240</u>

WELL LOCATION:  
sec. 33 T 3 N R 2 E 15F  
2 miles East of Holly Springs  
(distance) (direction) (nearest town)

WELL PURPOSE: Drinking  
(home, irrigation, municipal, industrial)

CODED

WELL COMPLETION DATA:

(1) diameter (inches) 4"

(2) total depth (feet) 240 feet

(3) static water level (feet) 180 feet below top of ground.

(4) casing PVC, 240 feet  
(material) (depth)

(size) if telescope see back.

(5) screen 74", 173 feet  
(length) (depth to top)

4", gravel waf  
(size) (material)

(6) pump 3/4 14  
(HP) (yield gpm)

(type power)

(7) electric log Elect.  
(yes or no)

(organization running log)


(8) how well bottom plugged 4' of

REGISTERED  
KILGORE  
AUG 6 1975

DRILLERS REMARKS:

If well telescopes please sketch and show depths.

GROUND LEVEL

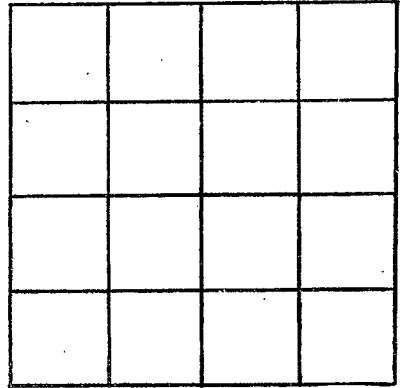

SECTION \_\_\_\_\_

Please indicate well location X.

ADDITIONAL INFORMATION

If more than one screen,  
show locations of each on sketch.