

CODED

MARSHALL
L30
9-18-75

MISSISSIPPI
BOARD OF WATER COMMISSIONERS
416 North State Street
Jackson, Mississippi 39201

WATER WELL DRILLERS LOG

SEPT 18 1975 Billy R. Simpson MARSHALL
date well completed firm name county well located

LANDOWNER:	description of formations encountered	from	to
JESSE L THOMPSON	SURFACE CLAY	0	15
Holly Springs Miss (mailing address)	WHITE CLAY & SAND	15	35
	SAND	35	65
	WHITE CLAY & SAND	65	90
	COARSE SAND	90	130

WELL LOCATION:
sec. 2 T. 3 N. R. 2 E.
1/2 S. W.
1/2 miles S of Haysville
(distance) (direction) (nearest town)

WELL PURPOSE: FOUNT
(home, irrigation, municipal, industrial)

WELL COMPLETION DATA:

(1) diameter (inches) 4

(2) total depth (feet) 130

(3) static water level (feet) 50 below/above top of ground.

(4) casing pvc (material), 12f (depth)

(size) If telescope see back.

(5) screen 6' (length), 124 (depth to top)

4" (size), pvc (material)

(6) pump 1/2 (HP), 10 (yield gpm)


Elec (type power)

(7) electric log No (yes or no)

(organization running log)


(8) how well bottom plugged pvc
cap

DRILLERS REMARKS:

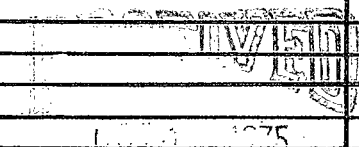

If well telescopes please sketch and show depths.

GROUND LEVEL

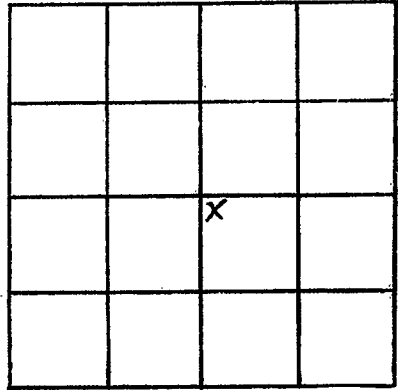

SECTION 2

Please indicate well location X.

ADDITIONAL INFORMATION

If more than one screen,
show locations of each on sketch.