

Marshall  
 L 2001  
 10-8-75

MISSISSIPPI  
 BOARD OF WATER COMMISSIONERS  
 416 North State Street  
 Jackson, Mississippi 39201

WATER WELL DRILLERS LOG

10-8 1975 Dean + Kent Bunker Marshall  
 date well completed firm name COI county well located

LANDOWNER:

Mary allie B W

Holly Springs, miss  
 (mailing address)

description of formations encountered

Sand

from

to

0 200

WELL LOCATION:


sec. 32 T. 3 N. R. 2 E. 15E  
 (S) (W)  
 2 miles north of Holly Springs  
 (distance) (direction) (nearest town)

WELL PURPOSE:

Drinking  
 (home, irrigation, municipal, industrial)

WELL COMPLETION DATA:

- (1) diameter (inches) 4"
- (2) total depth (feet) 200 feet
- (3) static water level (feet) 100 ft below top of ground
- (4) casing PVC, 200 ft.  
 (material) (depth)  
 (size) if telescope see back.
- (5) screen 193 feet.  
 (length) (depth to top)  
 4" gravel wall  
 (size) (material)
- (6) pump 3/4 HP, 14 yield gpm  
 (HP) (yield gpm)  
 (type power)
- (7) electric log Eled.  
 (yes or no)  
 (organization running log)
- (8) how well bottom plugged 4" cap

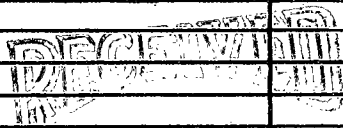


NOV 6 1975

DRILLERS REMARKS:

MISS. RD. OF WATER COMMISSIONERS

If well telescopes please sketch and show depths.

GROUND LEVEL

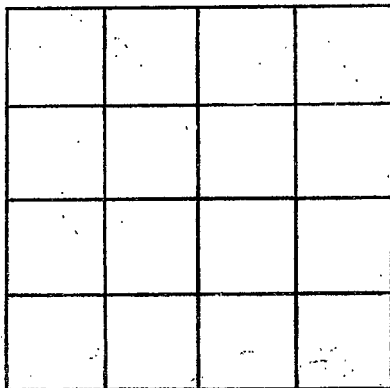

SECTION \_\_\_\_\_

Please indicate well location X.

ADDITIONAL INFORMATION

If more than one screen, show locations of each on sketch.