

Marshall
 L 2002
 7-12-76

MISSISSIPPI
 BOARD OF WATER COMMISSIONERS
 416 North State Street
 15E Jackson, Mississippi 39201

WATER WELL DRILLERS LOG

7-12 1976 date well completed
 Dean + Kat Bump well firm name
 Marshall county well located

LANDOWNER:
 Josephus Turnage
 Holly Springs, Miss.
 (mailing address)

description of formations encountered	from	to
clay	0	30
sand	30	190

WELL LOCATION:
 sec. 19 T 3 N R 2 E
 3 miles North of Holly Springs
 (distance) (direction) (nearest town)

WELL PURPOSE: Drinking
 (home, irrigation, municipal, industrial)

- WELL COMPLETION DATA:
- (1) diameter (inches) 4"
 - (2) total depth (feet) 190 feet
 - (3) static water level (feet) 90 below above top of ground.
 - (4) casing PVC 190 feet
 (material) (depth)
 If telescope see back.
 (size)
 - (5) screen 7 ft. 183 feet
 (length) (depth to top)
4" drilled well
 (size) (material)
 - (6) pump 3/4 14
 (HP) (yield gpm)

 (type power)
 - (7) electric log Elect.
 (yes or no)


 (organization running log)
 - (8) how well bottom plugged 4" cp.

RECEIVED
 AUG 12 1976
 MISS. BD. OF WATER COMMISSIONERS

DRILLERS REMARKS:

If well telescopes please
sketch and show depths.

GROUND LEVEL

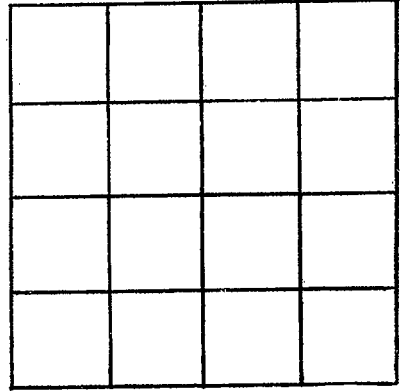

SECTION _____

Please indicate well location X.

ADDITIONAL INFORMATION

If more than one screen,
show locations of each on sketch.