

MARSHALL
 L 2003
 5/4/76

MISSISSIPPI
 BOARD OF WATER COMMISSIONERS
 416 North State Street
 Jackson, Mississippi 39201

WATER WELL DRILLERS LOG

MAY 4 1976 *Billy R. Simpson* MARSHALL
 date well completed firm name county well located

LANDOWNER:
 WHEELER BOLDEN
 Holly Springs, Miss
 (mailing address)

WELL LOCATION:
 sec. 2 T 3 N R 2 E
 S W
 1 miles S of Heaverville
 (distance) (direction) (nearest town)

description of formations encountered	from	to
SURFACE CLAY	0	15
COARSE SAND	15	87
WHITE CLAY	87	103
SAND	103	111
WHITE CLAY	111	123
SAND	123	141

WELL PURPOSE: *Home*
 (home, irrigation, municipal, industrial)

WELL COMPLETION DATA:

(1) diameter (inches) 4

(2) total depth (feet) 145

(3) static water level (feet) 56 below above top of ground.

(4) casing PVC 139
 (material) (depth)

 if telescope see back.
 (size)

(5) screen 6' 139
 (length) (depth to top)

4" PVC
 (size) (material)

(6) pump 1/2 10
 (HP) (yield gpm)

Elec
 (type power)

(7) electric log no
 (yes or no)

 (organization running log)

(8) how well bottom plugged PVC CAP


RECEIVED
 SEP - 2 1976

MISS. Bd. OF WATER COMMISSIONERS

DRILLERS REMARKS:

If well telescopes please sketch and show depths.

GROUND LEVEL

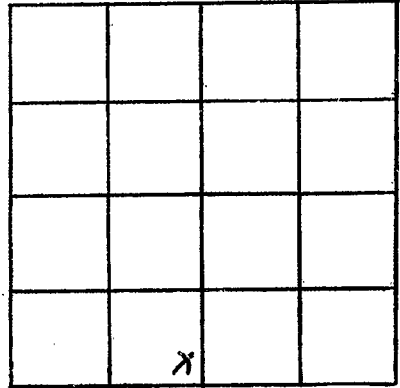

SECTION 2

Please indicate well location X.

ADDITIONAL INFORMATION

If more than one screen, show locations of each on sketch.