

Marshall
 L 2004
 11-3-76

MISSISSIPPI
 BOARD OF WATER COMMISSIONERS
 416 North State Street
 15F Jackson, Mississippi 39201

WATER WELL DRILLERS LOG

11-3 1976 Reynolds & Reynolds Marshall
 date well completed firm name county well located

LANDOWNER:

description of formations encountered

from to

Eugene Calton

clay

0 20

Holly Springs, Miss.
 (mailing address)

sand

20 90

WELL LOCATION:

sec. 24 T 3 N R 2 E
 (S) (W)
 5 miles East of Holly Springs
 (distance) (direction) (nearest town)

WELL PURPOSE: Drinking
 (home, irrigation, municipal, industrial)

WELL COMPLETION DATA:

- (1) diameter (inches) 4"
- (2) total depth (feet) 220 feet
- (3) static water level (feet) 165 below above top of ground.
- (4) casing PVC 220 feet
 (material) (depth)
 _____ if telescope see back.
 (size)
- (5) screen 24" 213 feet
 (length) (depth to top)
4" gravel wall
 (size) (material)
- (6) pump 3/4 17
 (HP) (yield gpm)

 (type power)
- (7) electric log yes
 (yes or no)

 (organization running log)
- (8) how well bottom plugged 4" cap

DRILLERS REMARKS:


RECEIVED

DEC 13 1976

MISS. BD. OF WATER COMMISSIONERS

If well telescopes please sketch and show depths.

GROUND LEVEL

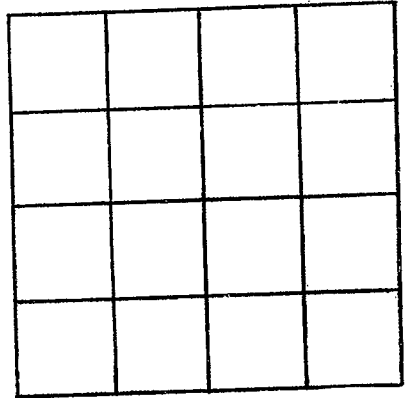

SECTION _____

Please indicate well location X.

ADDITIONAL INFORMATION

If more than one screen, show locations of each on sketch.