

MARSHALL

L

7-18-76

2005

July 18 1976 date well completed

MISSISSIPPI BOARD OF WATER COMMISSIONERS 416 North State Street Jackson, Mississippi 39201

WATER WELL DRILLERS LOG

R.L. Carpenter firm name

Marshall county well located

LANDOWNER: Mike Slodge

Hobsonville, Miss

R.F.D.

(mailing address)

WELL LOCATION:

sec. 12 T 3 N R 2 E S W 3 miles Southeast of Hobsonville (distance) (direction) (nearest town)

WELL PURPOSE: Home (home, irrigation, municipal, industrial)

WELL COMPLETION DATA:

- (1) diameter (inches) 4
(2) total depth (feet) 210
(3) static water level (feet) 130 below top of ground.
(4) casing Plastic, 264' (material) (depth)
(5) screen 6' (length), 264' (depth to top)
(6) pump 3/4 (HP), 10 (yield gpm)
(7) electric log No (yes or no)

(organization running log)

(8) how well bottom plugged Plastic cap

DRILLERS REMARKS:

description of formations encountered

from

to


Table with 3 columns: description of formations encountered, from, to. Rows include: Surface Soil (1-2.3), 1st coarse white sand (2.3-65), coarse white sand (65-126), white clay (126-148), white coarse sand (148-210).

RECEIVED MAY 12 1978

MISS. Bd. OF WATER COMM

If well telescopes please sketch and show depths.

GROUND LEVEL

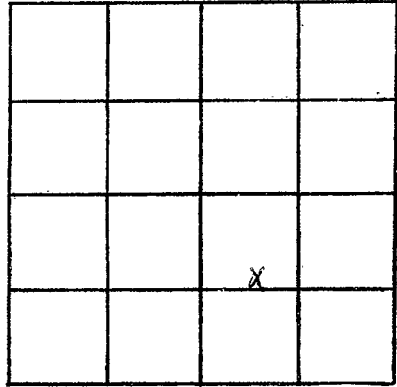

SECTION 12

Please indicate well location X.

ADDITIONAL INFORMATION

If more than one screen,  
show locations of each on sketch.