

MARSHALL

L

7-25-76

2006

July 25 1976

date well completed

MISSISSIPPI  
BOARD OF WATER COMMISSIONERS  
416 North State Street  
Jackson, Mississippi 39201

## WATER WELL DRILLERS LOG

R. L. Carpenter

firm name

Marshall

county well located


LANDOWNER: Robert Russon

Holly Springs

Miss. RFD

(mailing address)

## WELL LOCATION:

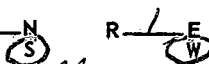sec. 18-T 3 R-1 E  
  
 7 miles Southeast of Holly Springs  
 (distance) (direction) (nearest town)

WELL PURPOSE: Home  
 (home, irrigation, municipal, industrial)

## WELL COMPLETION DATA:

(1) diameter (inches) 4  
 (2) total depth (feet) 250  
 (3) static water level (feet) 170 below  
 top of ground.

(4) casing Plastic, 244'  
 (material) (depth)

(size) if telescope see back.

(5) screen 6', 244'  
 (length) (depth to top)

4", Plastic & Gravel  
 (size) (material)

(6) pump 3/4, 18  
 (HP) (yield gpm)

5 hp  
 (type power)

(7) electric log No  
 (yes or no)

(organization running log)

(8) how well bottom plugged Plastic Cap

description of formations  
encountered

from

to

description of formations encountered	from	to
Surface Soil	0	23
Med. Red Sand	23	55
White med. Sand	55	130
White clay	130	168
White Fine Sand	168	218
White Coarse Sand	218	250


DRILLERS REMARKS:

RECEIVED  
MAY 12 1978

MISS. BD. OF WATER COMM

If well telescopes please sketch and show depths.

GROUND LEVEL

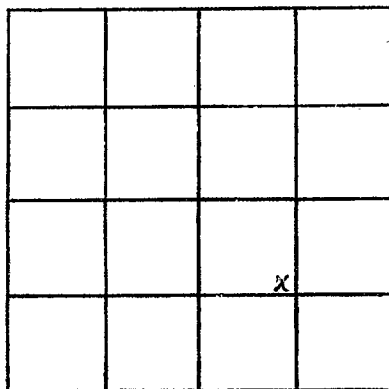

SECTION 18

Please indicate well location X.

ADDITIONAL INFORMATION

If more than one screen,  
show locations of each on sketch.