

MARSHALL

L

5/24/78

2007

MISSISSIPPI
 BOARD OF WATER COMMISSIONERS
 416 North State Street
 Jackson, Mississippi 39201

WATER WELL DRILLERS LOG

5-24 1978 Wilson Well Co, Inc Marshall
 date well completed firm name county well located

LANDOWNER: Jessie Holland

Rt # 2 Box 152

Holly Springs
 (mailing address)

WELL LOCATION:


sec. 1 T. 3 N. R. 2 E. W
 (distance) miles (direction) of (nearest town)

WELL PURPOSE:
 (home, irrigation, municipal, industrial)

WELL COMPLETION DATA:

- (1) diameter (inches) 4
- (2) total depth (feet) 179
- (3) static water level (feet) 120 below above top of ground.
- (4) casing 4 / 169
 (material) (depth)
4 if telescope see back.
 (size)
- (5) screen 10 / 169
 (length) (depth to top)
- (6) pump 3/4 / 10
 (HP) (yield gpm)
Leatronics
 (type power)
- (7) electric log (yes or no) _____
 (organization running log) _____
- (8) how well bottom plugged 4"
plastic cap

description of formations encountered	from	to
Red clay	0	10
Red Sand	10	15
Red Sand & white clay	15	30
Red Sand & white Sand	30	45
white Sand	45	118
white clay	118	125
white Sand	125	150
white Sand & white clay	150	157
white Sand	157	180

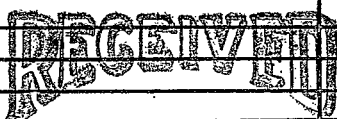

JUN 26 1978

MISS. Bd. of Water Comm

DRILLERS REMARKS:

