

MARSHALL  
L  
7-18-78  
2008

MISSISSIPPI  
BOARD OF WATER COMMISSIONERS  
416 North State Street  
Jackson, Mississippi 39201

WATER WELL DRILLERS LOG


7-18 1978 Dean & Keit Bumpas Wells MARSHALL  
date well completed firm name county well located

LANDOWNER:	description of formations encountered	from	to
JOSEPH FERRELL	clay	0	45
HOLLY SPRINGS, MISS. (mailing address)	sand	45	237
<b>WELL LOCATION:</b> sec. <u>33</u> T. <u>3</u> N. R. <u>2</u> E. <u>2</u> miles <u>EAST</u> of <u>H. S.</u> (distance) (direction) (nearest town)			
<b>WELL PURPOSE:</b> <u>Dwelling</u> (home, irrigation, municipal, industrial)			
<b>WELL COMPLETION DATA:</b>			
(1) diameter (inches) <u>4"</u>			
(2) total depth (feet) <u>237 feet</u>			
(3) static water level (feet) <u>167</u> below top of ground.			
(4) casing <u>PVC</u> , <u>237 feet</u> (material) (depth)			
(size) If telescope see back.			
(5) screen <u>7ft.</u> , <u>230 feet</u> (length) (depth to top)			
<u>4"</u> , <u>GRAVEL WALL</u> (size) (material)			
(6) pump <u>3/4</u> <u>14</u> (HP) (yield/gpm)			
(type power)			
(7) electric log <u>Elect.</u> (yes or no)			
(organization running log)			
(8) how well bottom plugged <u>4" cof.</u>			
DRILLERS REMARKS:			

RECEIVED  
AUG 14 1978

If well telescopes please sketch and show depths.

GROUND LEVEL

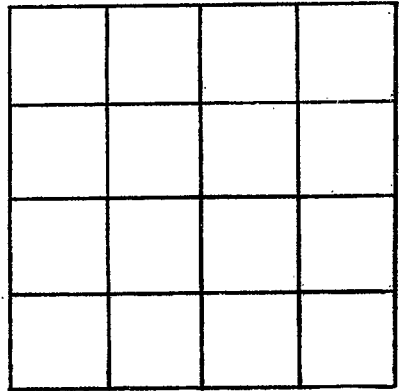

SECTION \_\_\_\_\_

Please indicate well location X.

ADDITIONAL INFORMATION

If more than one screen,  
show locations of each on sketch.