

MARSHALL
L
7-24-78
2009

MISSISSIPPI
BOARD OF WATER COMMISSIONERS
416 North State Street
Jackson, Mississippi 39201

WATER WELL DRILLERS LOG

July 24 1978 W. Marshall Marshall
date well completed firm name county well located


LANDOWNER:	description of formations encountered	from	to
(mailing address)			
<u>Jack Payne</u> <u>650 Ditches Rd. Dr.</u> <u>Caldecott</u>			
WELL LOCATION: sec <u>17</u> <u>T</u> <u>3</u> <u>N</u> <u>S</u> <u>R</u> <u>1</u> <u>E</u> <u>W</u> (distance) miles (direction) of (nearest town)	<u>Red Sands Red Clay</u>	<u>0</u>	<u>15</u>
	<u>White Clay</u>	<u>15</u>	<u>60</u>
	<u>White Clay White Sand</u>	<u>60</u>	<u>70</u>
	<u>White Sand</u>	<u>70</u>	<u>100</u>
WELL PURPOSE: (home, irrigation, municipal, industrial)			
WELL COMPLETION DATA:			
(1) diameter (inches) <u>4</u>			
(2) total depth (feet) <u>98</u>			
(3) static water level (feet) <u>10</u> below above top of ground.			
(4) casing <u>PVC</u> <u>88</u> (material) (depth)			
<u>4</u> If telescope see back. (size)			
(5) screen <u>10</u> <u>90</u> (length) (depth to top)			
<u>gravel packed</u> (size) (material)			
(6) pump <u>3/4</u> <u>10</u> (HP) (yield gpm)			
<u>electric</u> (type power)			
(7) electric log <input checked="" type="checkbox"/> (yes or no)			
(organization running log)			
(8) how well bottom plugged <u>4"</u> <u>plastic cap</u>			
DRILLERS REMARKS:			

RECEIVED
OCT 23 1978

MISS. BD. OF WATER COM. ✓

If well telescopes please sketch and show depths.

GROUND LEVEL

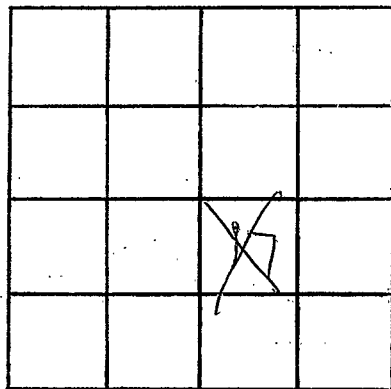

SECTION 17

Please indicate well location X.

ADDITIONAL INFORMATION

If more than one screen, show locations of each on sketch.