

MARSHALL
L
9-11-78
2010

MISSISSIPPI  
 BOARD OF WATER COMMISSIONERS  
 416 North State Street  
 Jackson, Mississippi 39201

WATER WELL DRILLERS LOG


9-11-78 date well completed      Hicks well co firm name      Marshall county well located

LANDOWNER: Sidney McAlister Holly Springs, Miss (mailing address)	Description of formations encountered	from	to
		0	20
	Red clay	20	80
	W.C. & SAND	80	145
	White SAND		

WELL LOCATION:  
 sec 23 T 3 N R 2 E  
 5 miles E of Holly Springs  
 (distance) (direction) (nearest town)

WELL PURPOSE: BOEN  
 (home, irrigation, municipal, industrial)

- WELL COMPLETION DATA:
- (1) diameter (inches) 4"
  - (2) total depth (feet) 145
  - (3) static water level (feet) 40 below top of ground.
  - (4) casing PVC (material), 145 (depth)
  - (size) If telescope see back.
  - (5) screen 7' (length), 7' (depth to top)
  - 4202 Inside ROCK (size) (material)
  - (6) pump 1/2 (HP), 10 (yield gpm)
  - 220 F12C (type power)
  - (7) electric log NO (yes or no)
  - (organization running log)
  - (8) how well bottom plugged CAP

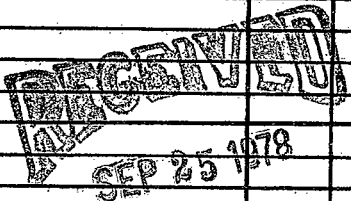


MISS. BU. OF WATER COMMISSIONERS

DRILLERS REMARKS:

If well telescopes please sketch and show depths.

GROUND LEVEL

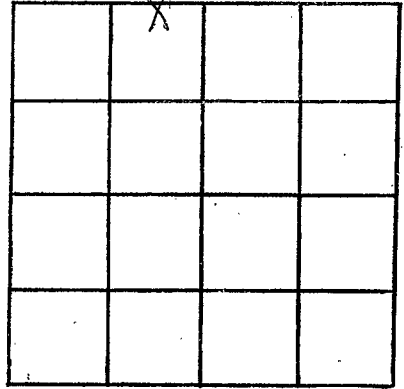

SECTION \_\_\_\_\_

Please indicate well location X.

ADDITIONAL INFORMATION

If more than one screen,  
show locations of each on sketch.