

| |
|----------|
| MARSHALL |
| L |
| 9-11-78 |
| 2011 |

MISSISSIPPI
 BOARD OF WATER COMMISSIONERS
 416 North State Street
 Jackson, Mississippi 39201

WATER WELL DRILLERS LOG

date well completed 9-11-78 firm name Dean Kentley Field county well located Marshall


| LANDOWNER: | description of formations encountered | from | to |
|--|---------------------------------------|-----------|------------|
| <u>Rubin Crumb</u> <u>Hals Struss miss</u> (mailing address) | | | |
| | <u>sand</u> | <u>20</u> | <u>160</u> |
| WELL LOCATION: | | | |
| sec. <u>2</u> T. <u>3</u> N. R. <u>2</u> E. | | | |
| <u>3</u> miles <u>West</u> of <u>Hubert</u> | | | |
| WELL PURPOSE: <u>Dweller</u> (home, irrigation, municipal, industrial) | | | |
| WELL COMPLETION DATA: | | | |
| (1) diameter (inches) <u>4"</u> | | | |
| (2) total depth (feet) <u>160 feet</u> | | | |
| (3) static water level (feet) <u>166</u> below above top of ground. | | | |
| (4) casing <u>PVC</u> <u>160 feet</u> (material) (depth) | | | |
| (size) if telescope see back. | | | |
| (5) screen <u>7 ft.</u> <u>153 feet</u> (length) (depth to top) | | | |
| <u>4"</u> <u>gravel wad</u> (size) (material) | | | |
| (6) pump <u>3/4</u> <u>14</u> (HP) (yield gpm) | | | |
| (type power) | | | |
| (7) electric log <u>Elect.</u> (yes or no) | | | |
| (organization running log) | | | |
| (8) how well bottom plugged <u>4' cf.</u> | | | |
| DRILLERS REMARKS: | | | |

RECEIVED
 NOV 17 1978

MISS. BD. OF WATER COMM

If well telescopes please
sketch and show depths.

GROUND LEVEL

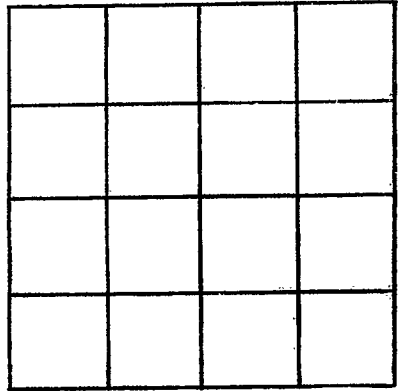

SECTION _____

Please indicate well location X.

ADDITIONAL INFORMATION

If more than one screen,
show locations of each on sketch.