

MARSHALL
 L 2062
 3-28-79

MISSISSIPPI
 BOARD OF WATER COMMISSIONERS
 416 North State Street
 Jackson, Mississippi 39201

WATER WELL DRILLERS LOG

3-3 19 79 Nicks Well Co. Marshall
 date well completed firm name county well located

| LANDOWNER: | description of formations encountered | from | to |
|---|---------------------------------------|------------|------------|
| (mailing address) | | | |
| <u>Dr. Cummins</u> <u>Holly Springs Miss.</u> | <u>Red Clay & sand</u> | <u>0</u> | <u>40</u> |
| | <u>Red sand & clay</u> | <u>40</u> | <u>190</u> |
| | <u>Clay & white sand</u> | <u>190</u> | <u>210</u> |
| | <u>white sand</u> | <u>210</u> | <u>240</u> |
| WELL LOCATION: sec. <u>35</u> T. <u>3</u> N. R. <u>2</u> E <u>2</u> miles <u>East</u> of <u>Holly Springs</u> (distance) (direction) (nearest town) | | | |
| WELL PURPOSE: <u>Drain</u> (home, irrigation, municipal, industrial) | | | |
| WELL COMPLETION DATA: | | | |
| (1) diameter (inches) <u>4</u> | | | |
| (2) total depth (feet) <u>240</u> | | | |
| (3) static water level (feet) <u>180</u> below top of ground. | | | |
| (4) casing <u>Plastic</u> , <u>240</u> (material) (depth) | | | |
| (size) if telescope see back. | | | |
| (5) screen <u>7 ft.</u> , <u>233 ft.</u> (length) (depth to top) | | | |
| <u>4 in.</u> , <u>Gravel</u> (size) (material) | | | |
| (6) pump <u>3/4</u> , <u>10</u> (HP) (yield gpm) | | | |
| <u>220</u> (type power) | | | |
| (7) electric log <u>NO</u> (yes or no) | | | |
| (organization running log) | | | |
| (8) how well bottom plugged <u>Cap.</u> | | | |
| DRILLERS REMARKS: | | | |


Miss. Board of Water Comm.

MAR 22 1979

RECEIVED

If well telescopes please sketch and show depths.

GROUND LEVEL

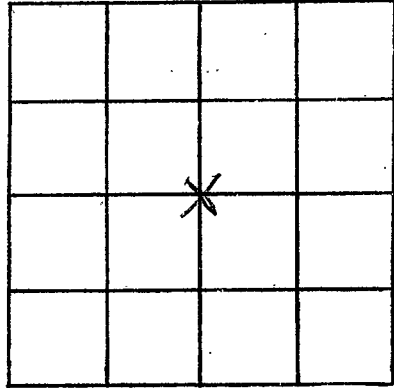

SECTION 35

Please indicate well location X.

ADDITIONAL INFORMATION

If more than one screen,
show locations of each on sketch.