

MARSHALL
L
9-17-76
2013

MISSISSIPPI
BOARD OF WATER COMMISSIONERS
416 North State Street
Jackson, Mississippi 39201

WATER WELL DRILLERS LOG

Sept. 17 1976 R.L. Carpenter Marshall
date well completed firm name county well located

LANDOWNER: Martha Tucker
Hudsonville, Miss.

(mailing address)
WELL LOCATION:
sec. 12 T 3 N R 2 E
3 miles South of Hudsonville
(distance) (direction) (nearest town)

WELL PURPOSE: Home
(home, irrigation, municipal, industrial)

- WELL COMPLETION DATA:
- (1) diameter (inches) 4
 - (2) total depth (feet) 218
 - (3) static water level (feet) 140 below top of ground.
 - (4) casing Plastic, 204 ft.
(material) (depth)
(size) if telescope see back.
 - (5) screen 6' 204'
(length) (depth to top)
4" Plastic
(size) (material)
 - (6) pump 3/4 10
(HP) (yield gpm)
Elec.
(type power)
 - (7) electric log No
(yes or no)
(organization running log)
 - (8) how well bottom plugged Plastic Cap


description of formations encountered	from	to
Surface Soil	0	18
Med Red Sand	18	38
Red coarse sand	38	55
Coarse white sand	55	110
White Clay	110	135
Med white sand	135	178
White coarse sand	178	218

DRILLERS REMARKS:

Miss. Board of Water Comm.
MAR 12 1979
RECEIVED

If well telescopes please sketch and show depths.

GROUND LEVEL

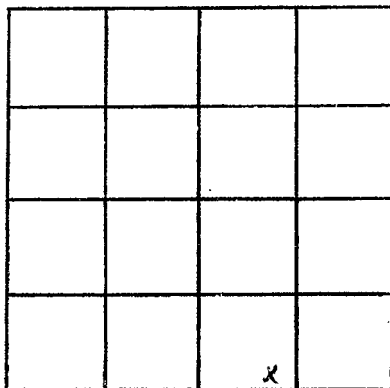

SECTION 12

Please indicate well location X.

ADDITIONAL INFORMATION

If more than one screen, show locations of each on sketch.