

MARSHALL

L

11-09-77

2014

MISSISSIPPI BOARD OF WATER COMMISSIONERS
416 North State Street
Jackson, Mississippi 39201

WATER WELL DRILLERS LOG

Nov. 9 1977
date well completed

R. L. Carpenter
firm name

Marshall
county well located

LANDOWNER: Ben Boga
Holy Springs
Miss.
(mailing address)

description of formations encountered	from	to
surface soil	0	25
med. white sand	25	60
white clay	60	95
white fine sand	95	130
white clay + fine sand	130	123
white coarse sand	172	218

WELL LOCATION:
sec. 29 T 3 N R 1 E
S W
6 miles northeast of Holy Springs
(distance) (direction) (nearest town)

WELL PURPOSE: Home
(home, irrigation, municipal, industrial)

WELL COMPLETION DATA:

- (1) diameter (inches) 4
- (2) total depth (feet) 218
- (3) static water level (feet) 190 below above top of ground.
- (4) casing Plastic (material), 208' (depth)
(size) if telescope see back.
- (5) screen 18' (length), 208' (depth to top)
4" (size), Plastic (material)
- (6) pump 3/4 (HP), 10 (yield gpm)
Elec. (type power)
- (7) electric log No (yes or no)

(organization running log)

(8) how well bottom plugged Full Cap

DRILLERS REMARKS:


Miss. Board of Water Comm.

MAR 12 1979

RECEIVED

If well telescopes please sketch and show depths.

GROUND LEVEL

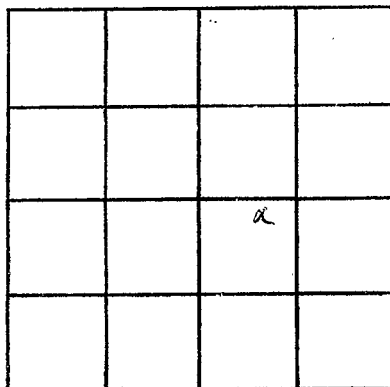

SECTION 29

Please indicate well location X.

ADDITIONAL INFORMATION

If more than one screen,
show locations of each on sketch.