

MARSHALL
L
2-14-79
2016
2-14

MISSISSIPPI
 BOARD OF WATER COMMISSIONERS
 416 North State Street
 Jackson, Mississippi 39201

WATER WELL DRILLERS LOG

date well completed 2-14-79 firm name Hicks Well Co county well located Marshall

LANDOWNER: Elton Iron Rt. 1
Lamar, Ms.
 (mailing address)

description of formations encountered	from	to
Red Clay	0	10
Red sand	10	90
White sand	90	140

WELL LOCATION:
 sec. 1 T. 3 N. R. 2 E.
1 miles S of Katmonville
 (distance) (direction) (nearest town)

WELL PURPOSE: None
 (home, irrigation, municipal, industrial)

- WELL COMPLETION DATA:
- diameter (inches) 4"
 - total depth (feet) 140
 - static water level (feet) 90 below above top of ground.
 - casing PVC, 140,
 (material) (depth)
 (size) if telescope see back.
 - screen 7, 133
 (length) (depth to top)
4", gravel type
 (size) (material)
 - pump 1/2, 10
 (HP) (yield gpm)
220V
 (type power)
 - electric log No
 (yes or no)
 (organization running log)
 - how well bottom plugged Cap

DRILLERS REMARKS:


Miss. Board of Water Comm.

FEB 22 1979

RECEIVED

If well telescopes please sketch and show depths.

GROUND LEVEL

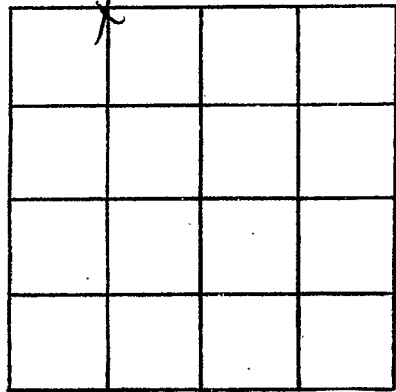

SECTION 1

Please indicate well location X.

ADDITIONAL INFORMATION

If more than one screen,
show locations of each on sketch.