

Marshall

L 2017

6-18-80

6-18 date well completed

MISSISSIPPI  
BOARD OF WATER COMMISSIONERS  
416 North State Street  
Jackson, Mississippi 39201

WATER WELL DRILLERS LOG

19 80 Donnell Construction firm name Marshall county well located

LANDOWNER:  
Biel Fitch  
Yocis Springs, Miss  
(mailing address)

description of formations encountered	from	to
<u>clay</u>	<u>0</u>	<u>20</u>
<u>sand</u>	<u>20</u>	<u>80</u>

WELL LOCATION:  
sec. 29 T. 3 N. R. 2 E  
4 miles east of Holly Springs  
(distance) (direction) (nearest town)

<u>clay</u>	<u>80</u>	<u>85</u>
<u>sand</u>	<u>85</u>	<u>190</u>

WELL PURPOSE: Domestic  
(home, irrigation, municipal, industrial)

- WELL COMPLETION DATA:
- (1) diameter (inches) 4"
  - (2) total depth (feet) 190 feet
  - (3) static water level (feet) 100 below top of ground.
  - (4) casing PVC, 190 feet (material) (depth)
  - (size) if telescope see back.
  - (5) screen 7 ft, 183 feet (length) (depth to top)
  - 1/2", gravel (size) (material)
  - (6) pump 3/4 (HP) 1/4 (yield gpm)
  - (type power)
  - (7) electric log Elect. (yes or no)
  - (organization running log)
  - (8) how well bottom plugged 24" cap.

DRILLERS REMARKS:


DEPT. OF NATURAL RESOURCES  
BUREAU OF LAND & WATER RESOURCES

JUL 16 1980

RECEIVED

If well telescopes please sketch and show depths.

GROUND LEVEL

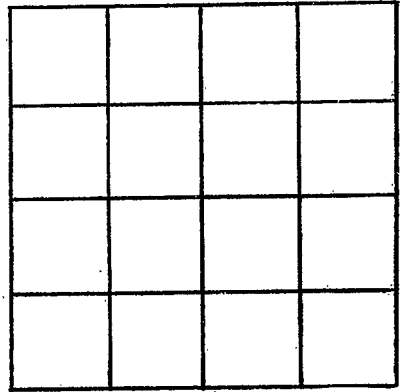

SECTION \_\_\_\_\_

Please indicate well location X.

ADDITIONAL INFORMATION

If more than one screen, show locations of each on sketch.