

Marshall
L
8-22-80
2018

MISSISSIPPI
BOARD OF WATER COMMISSIONERS
416 North State Street
Jackson, Mississippi 39201

WATER WELL DRILLERS LOG

8-22-80 date well completed
High Well Co. firm name
Marshall county well located

LANDOWNER: <u>Ernest Johnson</u>	description of formations encountered	from	to
<u>Rt. 3 Newardo Rd.</u>			
<u>Holly Springs, Ms.</u> (mailing address)	clay	0	30
	sand	30	160
WELL LOCATION: sec. <u>34</u> T. <u>3</u> N. R. <u>2</u> E. <u>2</u> miles (distance) <u>E</u> (direction) of <u>Holly Springs</u> (nearest town)	white sand	160	191
WELL PURPOSE: <u>None</u> (home, irrigation, municipal, industrial)			
WELL COMPLETION DATA:			
(1) diameter (inches) <u>4</u>			
(2) total depth (feet) <u>191</u>			
(3) static water level (feet) <u>140</u> below top of ground.			
(4) casing <u>PVC</u> (material), <u>191</u> (depth)			
_____ (size) If telescope see back.			
(5) screen <u>7</u> (length), <u>186</u> (depth to top)			
<u>4"</u> (size) <u>gravel type</u> (material)			
(6) pump <u>1/2</u> (HP), <u>10</u> (yield gpm)			
<u>220V</u> (type power)			
(7) electric log <u>No</u> (yes or no)			
_____ (organization running log)			
(8) how well bottom plugged <u>Cap</u>			
DRILLERS REMARKS:			


DEPT. OF NATURAL RESOURCES
BUREAU OF LAND & WATER RESOURCES

SEP 20 1980

RECEIVED

If well telescopes please sketch and show depths.

GROUND LEVEL

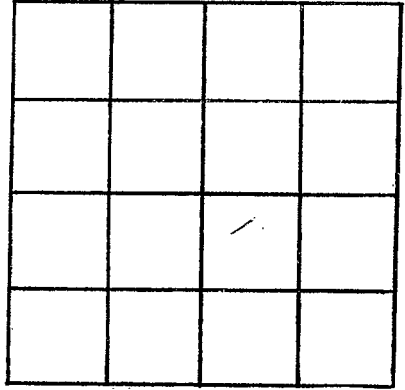

SECTION 340

Please indicate well location X.

ADDITIONAL INFORMATION

If more than one screen,
show locations of each on sketch.