

MISSISSIPPI DEPARTMENT OF NATURAL RESOURCES

Bureau of Land and Water Resources

Southport Mall

P.O. Box 10631

Jackson, Mississippi 39209

WATER WELL DRILLERS LOG

Marshall  
L 2000  
5-7-81

5-7-81 date well completed  
Hicks Well Co. firm name  
Marshall county well located

LANDOWNER: Carter Williams

description of formations encountered

from to

Holly Springs, Mo.  
(mailing address)

White Sand & Clay 0 90

White Sand 90 185

WELL LOCATION:

sec. 30 T 3 N R 2 E  
1 miles NE of Holly Springs  
(distance) (direction) (nearest town)

WELL PURPOSE: Home  
(home, irrigation, municipal, industrial)

WELL COMPLETION DATA:

- (1) diameter (inches) 4
- (2) total depth (feet) 185
- (3) static water level (feet) 100 below above top of ground.
- (4) casing PVC 185  
(material) (depth)

— If telescope see back.  
(size)

- (5) screen 12 173  
(length) (depth to top)

4" gravel & slotted  
(size) (material)

- (6) pump 1/2 10  
(HP) (yield gpm)

220V  
(type power)

- (7) electric log No  
(yes or no)

(organization running log)


- (8) how well bottom plugged Cap



DRILLERS REMARKS:

If well telescopes please sketch and show depths.

GROUND LEVEL

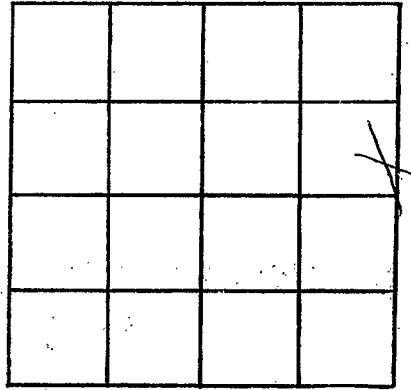

SECTION     

Please indicate well location X.

ADDITIONAL INFORMATION

If more than one screen,  
show locations of each on sketch.