

MISSISSIPPI DEPARTMENT OF NATURAL RESOURCES

Bureau of Land and Water Resources

Southport Mall

P.O. Box 10631

Jackson, Mississippi 39209

WATER WELL DRILLERS LOG

Marshall
L
8-10-82
2022

8-10-82
 date well completed

Wilson Well Co
 firm name

Marshall
 county well located

LANDOWNER:	description of formations encountered	from	to
Jimmy Dorrnell Rt 2 Box 327 Holly Springs, Miss. (mailing address)	Red Clay - White Sand White clay - white sand White Sand	0 30 60	30 60 75
WELL LOCATION: sec. <u>4</u> T. <u>3</u> N. R. <u>2</u> E. <u>one</u> miles <u>S</u> of <u>Nudsonville</u> (distance) (direction) (nearest town)			
WELL PURPOSE: <u>Home</u> (home, irrigation, municipal, industrial)			
WELL COMPLETION DATA: (1) diameter (inches) <u>4</u> (2) total depth (feet) <u>75</u> (3) static water level (feet) <u>20</u> below top of ground. (4) casing <u>Plastic</u> (material), (depth) <u>4</u> (size) if telescope see back. (5) screen <u>10</u> (length), (depth to top) <u>4</u> (size), <u>Plastic</u> (material) (6) pump <u>3/4</u> (HP), <u>10</u> (yield gpm), <u>electric</u> (type power) (7) electric log <u>No</u> (yes or no) (organization running log) (8) how well bottom plugged <u>Plastic Cap 4"</u>			
DRILLERS REMARKS:			


DEPT. OF NATURAL RESOURCES
 BUREAU OF LAND & WATER RESOURCES

SEP - 9 1982

RECEIVED

If well telescopes please sketch and show depths.

GROUND LEVEL

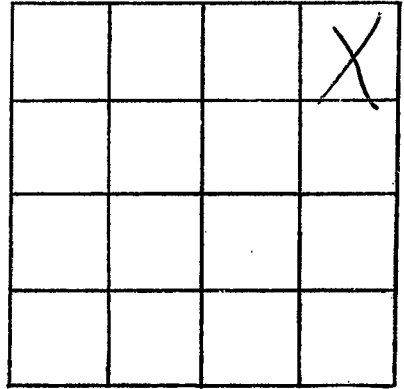

SECTION 7

Please indicate well location X.

ADDITIONAL INFORMATION

If more than one screen,
show locations of each on sketch.