

MISSISSIPPI DEPARTMENT OF NATURAL RESOURCES

Bureau of Land and Water Resources

Southport Mall

P.O. Box 10631

Jackson, Mississippi 39209

WATER WELL DRILLERS LOG

Marshall
L
2024

8-16 1984
date well completed

HICKS WELL CO.

RT# on name 157

Sanatobia, MS 38660

Marshall
county well located

LANDOWNER: Chester Kimmone

description of formations encountered

from

to

Rt. 1

Holly Springs Ms 38635
(mailing address)

Red Clay

0

20

Red Sand

20

50

WELL LOCATION:

sec. 18 T 3 N R 1 E
(S) (W)
6 miles NE of Holly Springs
(distance) (direction) (nearest town)

White Clay + sand

50

148

White sand

140

250

WELL PURPOSE:

Home
(home, irrigation, municipal, industrial)

WELL COMPLETION DATA:

(1) diameter (inches) 4
(2) total depth (feet) 250
(3) static water level (feet) 200 below above top of ground.

(4) casing PVC, 250,
(material) (depth)
4"
(size) if telescope see back.

(5) screen 10', 240'
(length) (depth to top)
1010, PVC
(size) (material)

(6) pump 3/4, 10
(HP) (yield gpm)
220V
(type power)

(7) electric log No
(yes or no)
(organization running log)

(8) how well bottom plugged Cg

DRILLERS REMARKS:


DEPT. OF NATURAL RESOURCES
BUREAU OF LAND & WATER RESOURCES

SEP 24 1984

RECEIVED

If well telescopes please sketch and show depths.

GROUND LEVEL

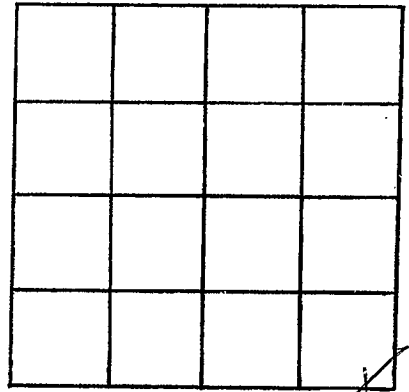

SECTION 18

Please indicate well location X. (

ADDITIONAL INFORMATION

If more than one screen,
show locations of each on sketch.