

**MISSISSIPPI DEPARTMENT OF NATURAL RESOURCES**  
Bureau of Land and Water Resources

P.O. Box 10631  
Jackson, Mississippi 39209  
**WATER WELL DRILLERS LOG**

COUNTY WELL LOCATED <b>Marshall</b>	
WELL NUMBER <b>L</b>	CODED
<b>2026</b>	
DATE WELL COMPLETED <b>9-1-87</b>	

PERMIT NUMBER
NAME OF DRILLING FIRM <b>HICKS WELL COMPANY</b>
<b>RT. 1 - BOX 157</b>

NAME & MAILING ADDRESS OF LANDOWNER <b>John Boone</b> <b>Rt # 1</b> <b>Holly Springs, MS 38635</b>		
WELL LOCATION: SEC	TOWNSHIP	RANGE
<b>17</b>	<b>3</b>	<b>2</b>
DISTANCE	DIRECTION	NEAREST TOWN
<b>6</b> Miles	<b>E</b>	of <b>Holly Springs</b>
OTHER LANDMARK		
WELL PURPOSE: <input checked="" type="radio"/> Home Irrigation, Municipal, Industrial, Fish Pond, etc.		

PUMP DATA		
PUMP TYPE (Circle One): <input checked="" type="radio"/> Submersible, Turbine, Jet, Flowing Well, Other (Describe) _____		
POWER TYPE (Circle One): <input checked="" type="radio"/> Electric, Tractor, Diesel, Gasoline, Butane, Other (Describe) _____		
Pump Capacity (GPM) <b>10</b>	No. of Stages <b>7</b>	Setting Depth <b>220</b> FT.
PUMP TEST		
Well yielded _____ GPM with a drawdown of _____ ft. after _____ hours of pumping		

WELL DATA		
Well Depth <b>260'</b>	Casing Diameter (In.) <b>4"</b>	Casing Length (Ft.) <b>250'</b>
Type of Casing <b>PVC</b>	Hole Depth <b>260'</b>	Depth to Static Water Level <b>180'</b>
TYPE OF COMPLETION: (Circle One or More): Gravel Packed, Underreamed, Telescoped, Natural Development, Open Hole, Other (Describe) <b>PVC Cap</b>		
Top of Lap Pipe or Reduction in Casing <b>FEET</b> IF TELESKOPED OR MORE THAN ONE SCREEN: USE BACK PAGE		

LOG DATA	
TYPE OF LOG RUN (Circle One): No Log Run, Electric, Gamma Ray, Density, Sonic, Neutron, Other (Describe) _____	
Name of Organization Running Log	

SCREEN DATA		
Diameter - Inches <b>4"</b>	Length - Feet <b>10'</b>	Slot Size - Inches <b>.013</b>
Screen Type <b>PVC</b>	Depth to Bottom - Feet <b>260'</b>	


GEOLOGIC DATA (Office Use Only)			
Surface Elev.	Geologic Unit	Unit Thickness	Depth to Top
Subs. SWL	Date	Analysis	Aquifer Test
Driller's Remarks			

DESCRIPTION OF FORMATIONS ENCOUNTERED	FROM	TO	FORMATIONS (Continued)	FROM	TO
<b>Red Clay</b>	<b>0</b>	<b>10</b>	<b>RECEIVED</b> <b>NOV 09 1987</b> <b>Department of Natural Resources</b> <b>Bureau of Land &amp; Water Resources</b>		
<b>Red sand</b>	<b>10</b>	<b>30</b>			
<b>White sand</b>	<b>30</b>	<b>260</b>			

IF MORE SPACE IS NEEDED, USE BACK

If well telescopes please  
sketch and show depths.

GROUND LEVEL

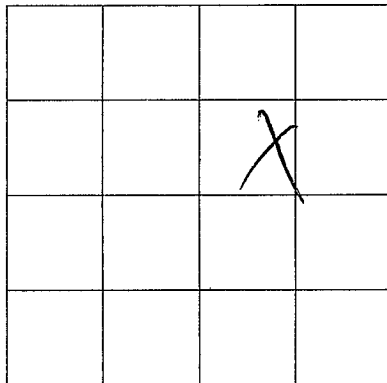

SECTION 17

Please indicate well location X.

ADDITIONAL INFORMATION

If more than one screen,  
show location of each on sketch.