

15E

CODED

MARSHALL
M 1
12-12-68

MISSISSIPPI  
BOARD OF WATER COMMISSIONERS  
416 North State Street  
Jackson, Mississippi 39201

CODED

WATER WELL DRILLERS LOG

12-12-19 68 Atkinson & Frost Marsh, 11  
 date well completed firm name county well located

LANDOWNER:  
Benny Newsom  
(mailing address)

description of formations encountered	from	to
Red Clay	0	15
Red sand	15	60
White sand	60	120

WELL LOCATION:  
 sec 23 T 3 N R 5 E  
8 miles (distance) of (direction) of (nearest town)

WELL PURPOSE:  
(home, irrigation, municipal, industrial)

- WELL COMPLETION DATA:
- (1) diameter (inches) 4 1/2
  - (2) total depth (feet) \_\_\_\_\_
  - (3) static water level (feet) 85 below above top of ground.
  - (4) casing PVC 1 1/2 (material) (depth)
  - \_\_\_\_\_ (size) if telescope see back.
  - (5) screen 5 Foot (length) (depth to top)
  - \_\_\_\_\_ (size) (material)
  - (6) pump 1/2 (HP) (yield gpm)
  - Elec (type power)
  - (7) electric log \_\_\_\_\_ (yes or no)
  - \_\_\_\_\_ (organization running log)
  - (8) how well bottom plugged \_\_\_\_\_

CODED

CODED


JAN 27 1969

MISS. DEPT. OF WATER RESOURCES

DRILLERS REMARKS:  
See Record

If well telescopes please sketch and show depths.

GROUND LEVEL

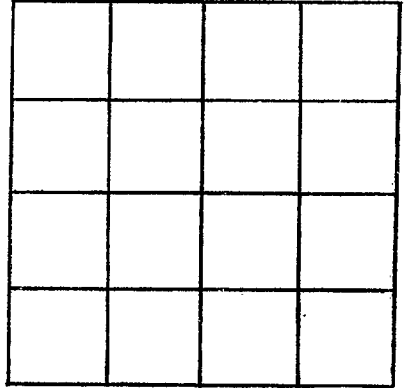

SECTION \_\_\_\_\_

Please indicate well location X.

ADDITIONAL INFORMATION

If more than one screen, show locations of each on sketch.