

15E

CODED

MISSISSIPPI BOARD OF WATER COMMISSIONERS

416 North State Street  
Jackson, Mississippi 39201

CODED

WATER WELL DRILLERS LOG

MARSHALL  
M2  
12-18-68

12-18 1968 ATKinson & Frost Marshall  
date well completed firm name county well located

LANDOWNER:

J. A. Ross

description of formations encountered

from to

Red Clay	0	15
Red sand	15	30
Sand gravel	30	50
white clay	50	75
sand	75	120
white sand	120	150

(mailing address)

WELL LOCATION:

sec 3 T 4 N R 5 E  
8 miles (distance) N (direction) Republic (nearest town)

WELL PURPOSE:

(home, irrigation, municipal, industrial)

WELL COMPLETION DATA:

- (1) diameter (inches) 4 1/2
- (2) total depth (feet)
- (3) static water level (feet) 100 below top of ground
- (4) casing PVC 140 (material) (depth)
- (size) If telescope see back.
- (5) screen (length) (depth to top) (size) (material)
- (6) pump 3/4 (HP) (yield gpm) Elec (type power)
- (7) electric log (yes or no) (organization running log)
- (8) how well bottom plugged

CODED

CODED

JAN 27 1969


MISS. Bd. of WATER COMMISSIONERS

DRILLERS REMARKS:

J. A. Ross

If well telescopes please sketch and show depths.

GROUND LEVEL

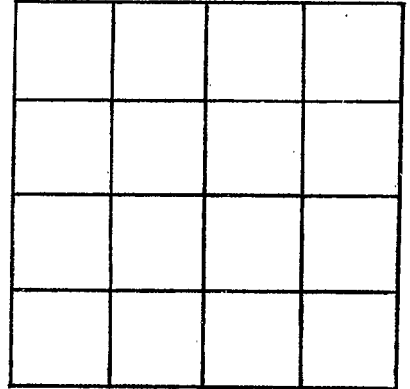

SECTION \_\_\_\_\_

Please indicate well location X.

ADDITIONAL INFORMATION

If more than one screen, show locations of each on sketch.