

15E

CODED

MARSHALL

M 3

12-21-68

MISSISSIPPI
 BOARD OF WATER COMMISSIONERS
 416 North State Street
 Jackson, Mississippi 39201

CODED

WATER WELL DRILLERS LOG

12-21 date well completed 1968 A. K. Reissel & Frost firm name Marshall county well located

LANDOWNER:

TOM McKEE

(mailing address)

description of formations encountered

from to

Red Clay	0	18
Red Sand	18	160
White Clay	100	120
White Sand	120	155

WELL LOCATION:

sec. 24 T 7 N R 5 E
 11 miles S of Baylis
 (distance) (direction) (nearest town)

WELL PURPOSE:

(home, irrigation, municipal, industrial)

WELL COMPLETION DATA:

- (1) diameter (inches) 4 1/2
- (2) total depth (feet) _____
- (3) static water level (feet) 98 below top of ground.
- (4) casing PVC, 145 (material) (depth)
- (size) if telescope see back.
- (5) screen 10 Foot (length) (depth to top)
- (size) (material)
- (6) pump 2 (HP) (yield gpm)
- Elec (type power)
- (7) electric log (yes or no)
- (organization running log)
- (8) how well bottom plugged _____

CODED

CODED

JAN 27 1969


MISS. DIV. OF WATER CONTROL

DRILLERS REMARKS:

See Record

If well telescopes please sketch and show depths.

GROUND LEVEL

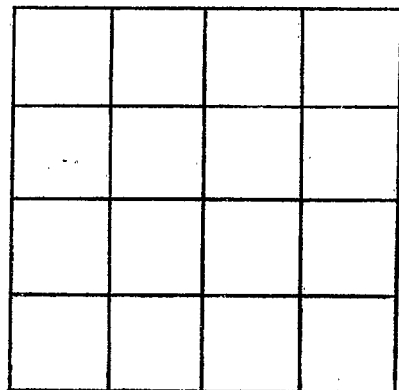

SECTION _____

Please indicate well location X.

ADDITIONAL INFORMATION

If more than one screen, show locations of each on sketch.