

Marshall
M4
5-69

MISSISSIPPI
BOARD OF WATER COMMISSIONERS
416 North State Street
Jackson, Mississippi 39201

CODED

WATER WELL DRILLERS LOG **CODED**

May 15th. 1969 W.A. Mason well Contractor Marshall


date well completed 19 firm name county well located

LANDOWNER: Mrs. Eva Beale
Route 3
Byhalia Miss.

description of formations encountered	from	to
	Very coarse white sand and egg size gravel rocks	19

(mailing address)

WELL LOCATION:

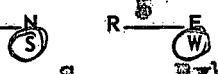sec. II T 4 N 5 R 5 E

8 1/2 miles S of Byhalia
 (distance) (direction) (nearest town)

WELL PURPOSE: Tenant house
 (home, irrigation, municipal, industrial)

WELL COMPLETION DATA:

- (1) diameter (inches) 4
- (2) total depth (feet) 20
- (3) static water level (feet) 6 below top of ground.
- (4) casing PVC plastic 20 ft.
 (material) (depth)
4 in. if telescope see back.
 (size)
- (5) screen none
 (length) (depth to top)
 (size) (material)
- (6) pump _____ (HP) _____ (yield gpm)
draw well
 (type power)
- (7) electric log no
 (yes or no)
 (organization running log)
- (8) how well bottom plugged not


CODED

DRILLERS REMARKS:
 recurb, put plastic casing
 inside old curb well &
 pumped on down below old
 curb

AUG 5 1969
 MISS. Bd. of
 WATER COMMISSIONERS

If well telescopes please sketch and show depths.

GROUND LEVEL

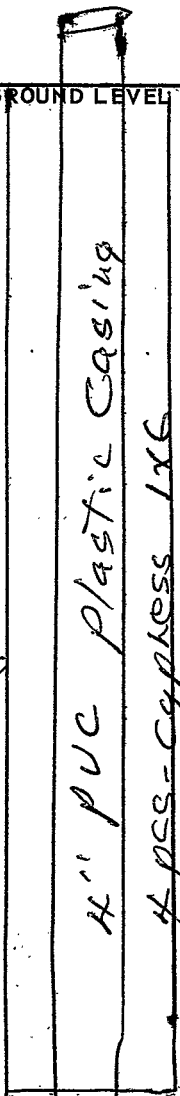

water level

61

~~*7/16*~~

191

*20' - white
coarse sand
T group*

If more than one screen, show locations of each on sketch.

	*		
	*		

SECTION _____

Please indicate well location X.

ADDITIONAL INFORMATION

Put 4 in. plastic casing
inside old square curb well
made by Lawrence Mason about
20 years ago