

Marshall
M5
7-2-69

MISSISSIPPI
 BOARD OF WATER COMMISSIONERS
 416 North State Street
 Jackson, Mississippi 39201

CODED

CODED

July 2nd, 1969

M WATER WELL DRILLERS LOG

Mason Well Contractors

19 W.A. Mason & Lawrence Mason Marshall

date well completed

firm name

county well located

LANDOWNER: Newson Eason
 Paid for W.C. McGrary Co., Inc.
Newson Eason Rt. 3 Byha lta

description of formations
 encountered

from

to

coarse white sand &
 gravel rocks Water bearing

85

88

(mailing address)

WELL LOCATION:

sec 13 T 4 N R 5 E
 (distance) (direction) (nearest town)

1 1/2 miles NE of Wall Hill
 (distance) (direction) (nearest town)

WELL PURPOSE:

(home, irrigation, municipal, industrial)

WELL COMPLETION DATA:

- (1) diameter (inches) 4 in.
- (2) total depth (feet) 88
- (3) static water level (feet) 70 below top of ground. CDT Plastic 88 ft.

(4) casing (material) (depth)
4 in. if telescope see back.
 (size)

(5) screen none (length) (depth to top)
 (size) (material)
none

(6) pump (HP) (yield gpm)
 (type power)

(7) electric log no (yes or no)
 (organization running log)

(8) how well bottom plugged not


CODED

AUG 5 1969
 MISSISSIPPI
 WATER BOARD

DRILLERS REMARKS: Recurb job
put 4 in. plastic casing
inside old 10 in. round
curb well made by Cha Riley Newson
appr. 20 years ago

If well telescopes please sketch and show depths.

GROUND LEVEL

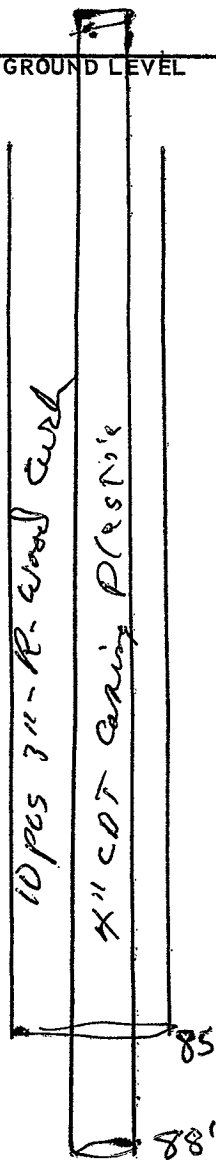

Coarse sand + rocks

If more than one screen, show locations of each on sketch.

SECTION 13

Please indicate well location X.

ADDITIONAL INFORMATION

Old curb in had rotted abt. 10 feet below ground well was easily cleaned out put plastic in & pumped about 3 feet below old well, left in extremely coarse white sand and small gravel rocks.