

Marshall
 M6
 8-9-69

MISSISSIPPI
 BOARD OF WATER COMMISSIONERS
 416 North State Street
 Jackson, Mississippi 39201

CODED

CODED

WATER WELL DRILLERS LOG

August 9th, 1969 W.A. Mason, Water Well Contractor - Marshall

date well completed

firm name

county well located

LANDOWNER: Wilson Estate
 Viola Wilson Malone
 Route 3, Byhalia Miss.

description of formations encountered

from

to

(mailing address)

WELL LOCATION:

sec. 13 T 4 N R 5 E
 1 1/2 miles NE Wall Hill
 (distance) (direction) (nearest town)

WELL PURPOSE:

(home, irrigation, municipal, industrial)

WELL COMPLETION DATA:

- (1) diameter (inches) 12 in. hole
- (2) total depth (feet) 50
- (3) static water level (feet) 44 below top of ground. 5 in. Styrene plastic casing
- (4) casing (material) (depth) 50 ft
- (5) screen (length) (depth to top)
- (6) pump (HP) (yield gpm)
- (7) electric log (yes or no)
- (8) how well bottom plugged Not


Hard dirt	1	12
Yellow clayish sand	12	15
Red sand	15	18
White loose sand	18	22
Yellow clay	22	28
Yellow sand	28	30
Red clay	30	32
Red sand	32	35
sand rock about 3 in. thick burst by 2 1/2 Dynamite	35	35
Yellow sand	35	37
Very coarse yellow sand	37	39
Hard red clay	39	42
Toned redish sand	42	44
Water bearing red dirty sand with small rocks	44	49
Water bearing pea gravel	49	50

DRILLERS REMARKS:

AUG 12 1969

If well telescopes please sketch and show depths.

GROUND LEVEL

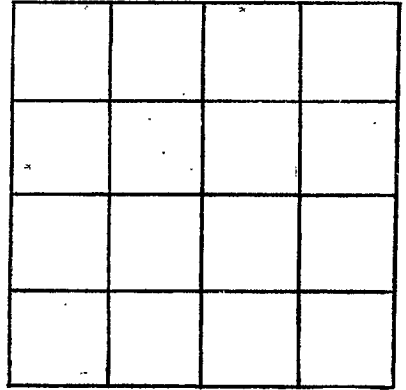

SECTION 13

Please indicate well location X.

ADDITIONAL INFORMATION

If more than one screen,
show locations of each on sketch.