

**MISSISSIPPI
BOARD OF WATER COMMISSIONERS
416 North State Street
Jackson, Mississippi 39201**

CODED

CODED

WATER WELL DRILLERS LOG

Marshall
M 7
8-16-69

August 16 th, 1969 W.A. Mason, Water Well Contractor Marshall
date well completed 19 firm name county well located

LANDOWNER:	description of formations	from	to
Sweetie Rodgers	Hard wire encountered	0	10
Route 5, Coldwater Miss.	Yellow clay	10	15
(mailing address)	Gravel	15	16
WELL LOCATION:	Red clay	16	20
sec. 14 T. 4 N R. 5 E	Red sand & gravel	20	25
XX I 3-4 (S) North Wall Hill (NW)	Coarse gummy red sand	25	30
(distance) miles (direction) of (nearest town)	sand over	30	
WELL PURPOSE: HOME	red clay	30	35
(home, irrigation, municipal, industrial)	hard white pipe clay	35	45
WELL COMPLETION DATA:	white sand	45	47
(1) diameter (inches) 12 in. hole	water bearing white sand	47	50
(2) total depth (feet) 55	white pipe clay	50	55
(3) static water level (feet) 47 Below top of ground.	rock & reddish sand	55	
5 in. styrene plastic casing			
(material) (depth)			
(size) If telescope see back.			
(5) screen NONE			
(length) (depth to top)			
(size) (material)			
(6) pump NONE			
(HP) (yield gpm)			
(type power)			
(7) electric log (yes or no)			
(organization running log)			
(8) how well bottom plugged NOT			
DRILLERS REMARKS:			


CODED

AUG 27 1969

WELL DRILLERS
ASSOCIATION

If well telescopes please sketch and show depths.

GROUND LEVEL

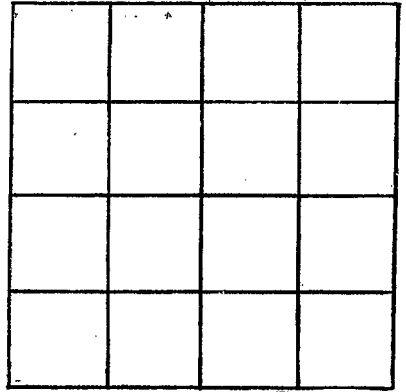

SECTION 14

Please indicate well location X.

ADDITIONAL INFORMATION

If more than one screen,
show locations of each on sketch.