

MISSISSIPPI
BOARD OF WATER COMMISSIONERS
416 North State Street
Jackson, Mississippi 39201

CODED

Job

WATER WELL DRILLERS LOG

September 15th 1969, W.A. Mason, Water Well Contractor

date well completed

firm name

county well located

Marshall County

LANDOWNER: James (Jim) Rodgers
Route 5, Coldwater Miss.

Description of formations
encountered

from

to

(mailing address)

WELL LOCATION:

sec. 23 T. 4 N. R. 5 E.
3-4 miles ~~away~~ north of Wall Hill
(distance) (direction) (nearest town)

WELL PURPOSE:

(home, irrigation, municipal, industrial)

WELL COMPLETION DATA:

- (1) diameter (inches) 4 in.
(2) total depth (feet) 70
(3) static water level (feet) 54 below
4 in. top of ground. above
(4) styrene plastic, 70 ft
casing (material) (depth)

(size) If telescope see back.

- (5) screen none
(length) (depth to top)

(size) (material)

- (6) pump none
(HP) (yield gpm)

(type power)

- (7) electric log (yes or no)

(organization running log)

- (8) how well bottom plugged not

DRILLERS REMARKS:


CODED

UCT 3 - 1969

ENCL. BD. OF
WATER COMMISSIONERS

If well telescopes please
sketch and show depths.

GROUND LEVEL

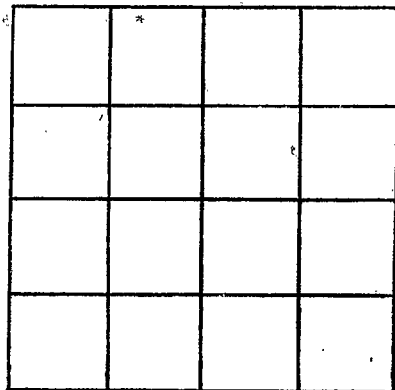

SECTION 23

Please indicate well location X.

ADDITIONAL INFORMATION

Recurbed old square curb
well made by Charley
someone approximately 28 yrs.
ago

If more than one screen,
show locations of each on sketch.