

CODED

MISSISSIPPI BOARD OF WATER COMMISSIONERS  
416 North State Street  
Jackson, Mississippi 39201

CODED

WATER WELL DRILLERS LOG

MARSHALL  
M9  
10-7-69

10-7-1969 date well completed  
Watson & Fast Marshall firm name  
county well located

LANDOWNER: John Kennedy  
(Watson, Miss.)  
Bally Springs Miss  
(mailing address)

description of formations encountered	from	to
red clay	0	18
red sandstone	18	40
white sand	40	135

WELL LOCATION:  
sec. 3 T 3 N R 5 E  
1 miles S of Watson  
(distance) (direction) (nearest town)

WELL PURPOSE:  
(home, irrigation, municipal, industrial)

WELL COMPLETION DATA:

(1) diameter (inches) 4"

(2) total depth (feet) 135

(3) static water level (feet) 90 below top of ground

(4) casing P.V.C. 125 (material) (depth)  
(size) if telescope see back.

(5) screen 10 125 (length) (depth to top)  
4 1/2" P.V.C. & sand (size) (material)

(6) pump 2 40 (HP) (yield gpm)  
Elec. (type power)

(7) electric log NO (yes or no)

(organization running log)

(8) how well bottom plugged CAP.

CODED


DRILLERS REMARKS:

NOV 3 1969

MISS. BD. OF WATER COM. .

If well telescopes please sketch and show depths.

GROUND LEVEL

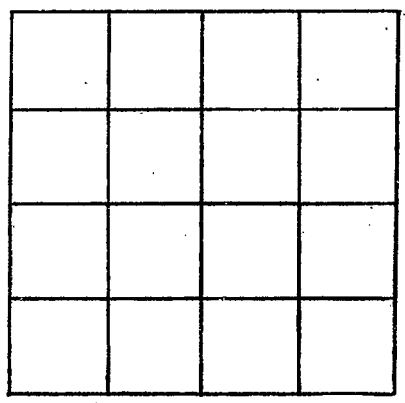

SECTION \_\_\_\_\_

Please indicate well location X.

ADDITIONAL INFORMATION

If more than one screen, show locations of each on sketch.