

CODED

Recomb Job

Marshall  
M 10  
10-7-69

MISSISSIPPI  
BOARD OF WATER COMMISSIONERS  
416 North State Street  
Jackson, Mississippi 39201

CODED

WATER WELL DRILLERS LOG

CODED

Oct. 7th - 19 69 W.A. Mason - water well Contractor  
date well completed firm name county well located Marshall Co.

LANDOWNER: Cora Jones description of formations encountered from to  
R.F.D. - no. 2  
Byhalia Miss. coarse white water  
(mailing address) bearing sand 78 80

WELL LOCATION:  
sec. 2 T 4 N R 5 E  
1 1/4 miles S of Woods  
(distance) (direction) (nearest town) Wilson

WELL PURPOSE:  
(home, irrigation, municipal, industrial)

- WELL COMPLETION DATA:
- (1) diameter (inches) 4"
  - (2) total depth (feet) 80 ft.
  - (3) static water level (feet) 63 below above top of ground
  - (4) casing (material) (depth) plastic 80'
  - (size) If telescope see back.
  - (5) screen none  
(length) (depth to top)
  - (size) (material)
  - (6) pump none  
(HP) (yield gpm)
  - (type-power)
  - (7) electric log (yes or no)
  - (organization running log)
  - (8) how well bottom plugged NOT

CODED

NOV 1969


MISS. Bd. of WATER COMMISSIONERS

DRILLERS REMARKS:

If well telescopes please sketch and show depths.

Label -  
Sam Bronson  
Lewis Jones  
John L. Wilson

GROUND LEVEL

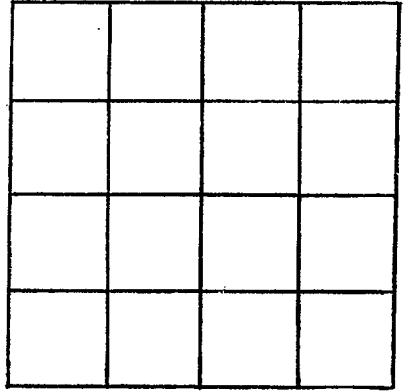

SECTION 2

Please indicate well location X.

ADDITIONAL INFORMATION

Reopened old well  
made by self & u  
July 1963 - REF -  
page 125 - put  
plastic inside of  
square cased well  
and pumped on down  
about two feet  
below old well

If more than one screen,  
show locations of each on sketch.