

Marshall
 M 11
 10-27-69

MISSISSIPPI
 BOARD OF WATER COMMISSIONERS
 416 North State Street
 Jackson, Mississippi 39201

CODED

WATER WELL DRILLERS LOG

CODED


10-27-1969 W. G. Mason - water well contractor Marshall Co.
 date well completed firm name county well located

LANDOWNER: <u>Don Johnson</u>	description of formations encountered	from	to
<u>Rt. 3-</u>			
<u>Byhalia Miss.</u> (mailing address)	<u>hard clay tint</u>	<u>0</u>	<u>8</u>
WELL LOCATION: sec. <u>11</u> T. <u>4</u> N R. <u>5</u> E <u>well</u> <u>2</u> miles <u>N</u> of <u>Beakes Sta.</u> (distance) (direction) (nearest town)	<u>gummy Red Sand</u>	<u>8</u>	<u>18</u>
WELL PURPOSE: <u>home</u> (home, irrigation, municipal, industrial)	<u>Red sand</u>	<u>18</u>	<u>20</u>
WELL COMPLETION DATA: (1) diameter (inches) <u>12" hole</u>	<u>white chrysl sand</u>	<u>20</u>	<u>22</u>
(2) total depth (feet) <u>50 FT.</u>	<u>white sand & gravel</u>	<u>22</u>	<u>24</u>
(3) static water level (feet) <u>25'</u> below top of ground.	<u>Red sand & gravel</u>	<u>24</u>	<u>25</u>
(4) casing <u>Styrene Plastic</u> <u>50'</u> (material) (depth)	<u>Red water bearing sand</u>	<u>25</u>	<u>26</u>
<u>4"</u> if telescope see back. (size)	<u>hard Red clay</u>	<u>26</u>	<u>27</u>
(5) screen <u>none</u> (length) (depth to top)	<u>introduced water bearing sand</u>	<u>27</u>	<u>47</u>
(size) (material)	<u>Red water bearing sand</u>	<u>47</u>	<u>50</u>
(6) pump <u>none</u> (HP) (yield gpm)			
(type power)			
(7) electric log (yes or no)			
(organization running log)			
(8) how well bottom plugged <u>not</u>			
DRILLERS REMARKS:			

NOV 2 1969

If well telescopes please sketch and show depths.

GROUND LEVEL

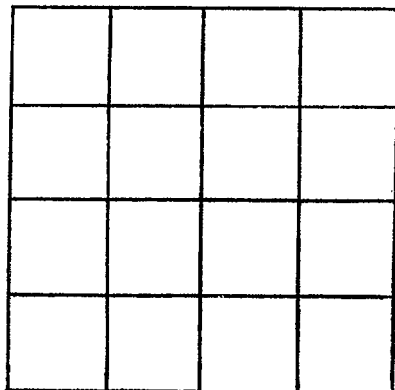

SECTION 11

Please indicate well location X.

ADDITIONAL INFORMATION

*old well made by
Doc Mason approx-
imately 30 yrs
ago*

If more than one screen,
show locations of each on sketch.