

Rec 016

MISSISSIPPI  
BOARD OF WATER COMMISSIONERS  
416 North State Street  
Jackson, Mississippi 39201

CODED

WATER WELL DRILLERS LOG  
W. A. MASON

CODED

Marshall  
M 12  
1-5-70

JANUARY 5TH 1970 date well completed  
WATER WELL CONTRACTOR W. A. MASON firm name  
MARSHALL CO. county well located

LANDOWNER: Hattie Echols  
Route 3, Box 111 D  
Byhalia Miss. 38611  
(mailing address)

description of formations encountered  
extremely coarse  
white water bearing  
sand and small gravel  
ROCKS

WELL LOCATION:  
sec. 1 T. 4 N. R. 5 E  
3 miles SE of Watson  
(distance) (direction) (nearest town)

from  
to  
14 16

WELL PURPOSE: Tenant House  
(home, irrigation, municipal, industrial)  
Gertrude Jones

- WELL COMPLETION DATA:
- (1) diameter (inches) 4"
  - (2) total depth (feet) 16'
  - (3) static water level (feet) 4' below top of ground.
  - (4) casing Pvc Plastic (material) 16' (depth)  
4" (size) if telescope see back.
  - (5) screen none (length) (depth to top)  
(size) (material)
  - (6) pump none (HP) (yield gpm)  
(type power)
  - (7) electric log (yes or no)  
(organization running log)
  - (8) how well bottom plugged not

CODED


JAN - 8 1970

MISS. BD. OF  
WATER COMM

DRILLERS REMARKS:

If well telescopes please sketch and show depths.

GROUND LEVEL

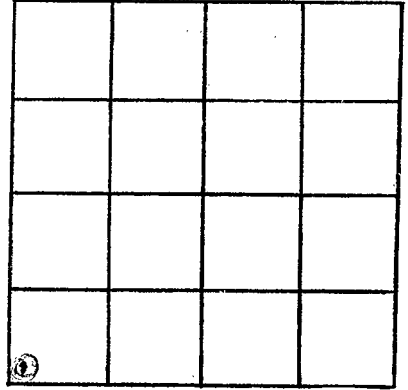

SECTION 1

Please indicate well location X.

ADDITIONAL INFORMATION

Remember - put 4" plastic casing inside old square cut (wood) well and pumped down about 2 feet below old well, old well made by Dock Mason approximately 20 years ago

If more than one screen, show locations of each on sketch.