

Recomb

Marshall  
M 13  
2-10-70

MISSISSIPPI  
BOARD OF WATER COMMISSIONERS  
416 North State Street  
Jackson, Mississippi 39201

**CODED**

**CODED**

WATER WELL DRILLERS LOG

Feb 10-1970 date well completed  
W. H. Mason water well Contr. firm name  
Marshall county well located

LANDOWNER:	description of formations encountered	from	to
M. R. STEVENS Sr. RT. 2 - Byhalia Miss. (mailing address)			
WELL LOCATION:	water bearing sand		
sec. 11 T. 4 N R. 5 E 2 1/2 miles South of Watson (distance) (direction) (nearest town)	pressur water 24 28		
WELL PURPOSE: <del>permanent house</del> (home, irrigation, municipal, industrial)			
WELL COMPLETION DATA:			
(1) diameter (inches) 4			
(2) total depth (feet) 24			
(3) static water level (feet) 14 below top of ground			
(4) casing PVC-plastic 24 (material) (depth)			
4" (size) if telescope see back.			
(5) screen none (length) (depth to top)			
(size) (material)			
(6) pump none (HP) (yield gpm)			
(type power)			
(7) electric log no (yes or no)			
(organization running log)			
(8) how well bottom plugged not			
DRILLERS REMARKS:			


**CODED**

FEB 20 1970

MISS. BD. OF  
WATER COMM.

If well telescopes please sketch and show depths.

GROUND LEVEL

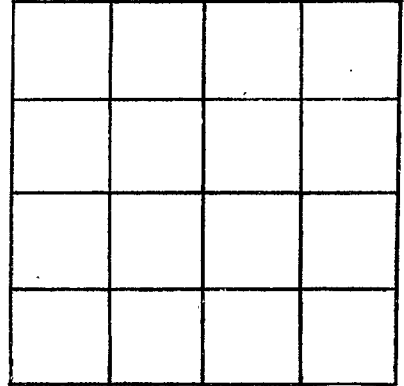

SECTION \_\_\_\_\_

Please indicate well location X.

ADDITIONAL INFORMATION

collected square  
wood comb water  
well made by DICK  
mason approx 20 yrs  
ago + put plastic  
in

If more than one screen, show locations of each on sketch.