

Marshall
 M 15
 6-28-70

MISSISSIPPI
 BOARD OF WATER COMMISSIONERS
 416 North State Street
 Jackson, Mississippi 39201

CODED

WATER WELL DRILLERS LOG

6-28-70 date well completed 19 Atkinson & Frost firm name county well located

LANDOWNER:
Willie C Jones
 (mailing address)

description of formations encountered	from	to
<u>clay</u>	<u>0</u>	<u>15</u>
<u>Red sand</u>	<u>15</u>	<u>70</u>
<u>Rock</u>	<u>70</u>	<u>72</u>
<u>White sand</u>	<u>72</u>	<u>140</u>

WELL LOCATION:
 sec 24 T 4 N R 5
2 miles E of WALL HILL
 (distance) (direction) (nearest town)

WELL PURPOSE:
 (home, irrigation, municipal, industrial)

- WELL COMPLETION DATA:
- (1) diameter (inches) 4 1/2
 - (2) total depth (feet) 140
 - (3) static water level (feet) _____ below/above top of ground.
 - (4) casing PVC 135
 (material) (depth)
 - (size) if telescope see back.
 - (5) screen 5 FT 135
 (length) (depth to top)
 - (size) (material)
 - (6) pump 1 10
 (HP) (yield gpm)
 - Elec
 (type power)
 - (7) electric log (yes or no) _____
 - (organization running log) _____
 - (8) how well bottom plugged _____

CODED


JUL 10 1970

DRILLERS REMARKS:

MISS. DE. OF
 WATER COMMISSIONERS

If well telescopes please sketch and show depths.

GROUND LEVEL

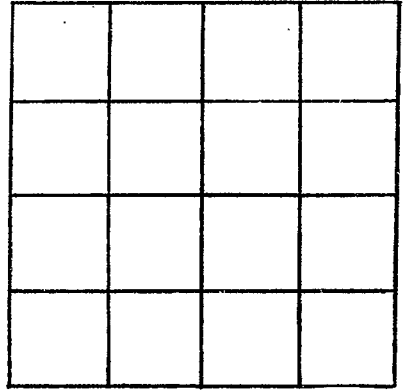

SECTION _____

Please indicate well location X.

ADDITIONAL INFORMATION

If more than one screen, show locations of each on sketch.