

MARSHALL
 M16
 70

MISSISSIPPI
 BOARD OF WATER COMMISSIONERS
 416 North State Street
 Jackson, Mississippi 39201

CODED

WATER WELL DRILLERS LOG

19 Atkinson & Frost Marshall

date well completed

firm name

county well located

LANDOWNER: Lester Washington

Byhalia Miss

(mailing address)

Description of formations encountered

from

to

Red Clay	0	15
White clay	15	50
White sand	50	115

WELL LOCATION:

sec. 4 T 4 N R 5 E
1 miles East of WALL MIL
 (distance) (direction) (nearest town)

WELL PURPOSE:

(home, irrigation, municipal, industrial)

WELL COMPLETION DATA:

- (1) diameter (inches) 4"
- (2) total depth (feet) 115'
- (3) static water level (feet) 78 below above top of ground.
- (4) casing P.V.C., 115'
 (material) (depth)
 (size) if telescope see back.
- (5) screen 10', 105'
 (length) (depth to top)
4", P.V.C.
 (size) (material)
- (6) pump 3/4, 10
 (HP) (yield gpm)
Elec.
 (type power)
- (7) electric log NO
 (yes or no)

(organization running log)

(8) how well bottom plugged C.B.P.

CODED


JAN 21 1971

MISS. DEPT. OF
 WATER RESOURCES

DRILLERS REMARKS:

If well telescopes please sketch and show depths.

GROUND LEVEL

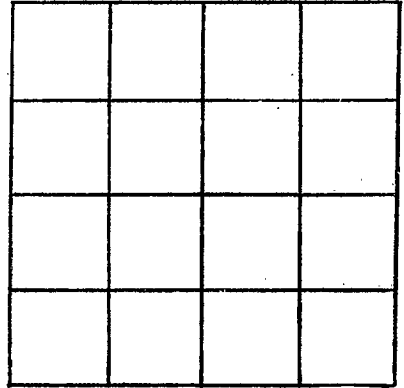

SECTION _____

Please indicate well location X.

ADDITIONAL INFORMATION

If more than one screen,
show locations of each on sketch.