

MARSHALL
M 18
5-19-71

MISSISSIPPI
 BOARD OF WATER COMMISSIONERS
 416 North State Street
 Jackson, Mississippi 39201

CODED

WATER WELL DRILLERS LOG

5-19 19 71 Deont Kent Burges well co. Marshall
 date well completed firm name county well located

LANDOWNER:	description of formations encountered	from	to
<u>Henry Dyle Shepleford</u> <u>At. 2. Cal Water, Miss</u> (mailing address)			
	<u>sand</u>	<u>20</u>	<u>160</u>
WELL LOCATION:			
sec. <u>27</u> T. <u>4</u> N. R. <u>5</u> E. <u>5</u> W.			
<u>2.2</u> miles <u>west</u> of <u>Healy</u> (distance) (direction) (nearest town)			
WELL PURPOSE: <u>Drinking</u> (home, irrigation, municipal, industrial)			
WELL COMPLETION DATA:			
(1) diameter (inches) <u>4"</u>			
(2) total depth (feet) <u>160 feet</u>			
(3) static water level (feet) <u>90 feet</u> below above top of ground.			
(4) casing <u>pvc</u> <u>160 feet</u> (material) (depth)			
(size) if telescope see back.			
(5) screen <u>6 ft</u> <u>154 feet</u> (length) (depth to top)			
<u>4"</u> <u>gravel wall</u> (size) (material)			
(6) pump <u>3/4</u> <u>10</u> (HP) (yield gpm)			
(type power)			
(7) electric log <u>electric</u> (yes or no)			
(organization running log)			
(8) how well bottom plugged <u>4" cof.</u>			
DRILLERS REMARKS:			


CODED

JUN 9 1971

MISS. BD. OF
 WATER COMM.

If well telescopes please sketch and show depths.

GROUND LEVEL

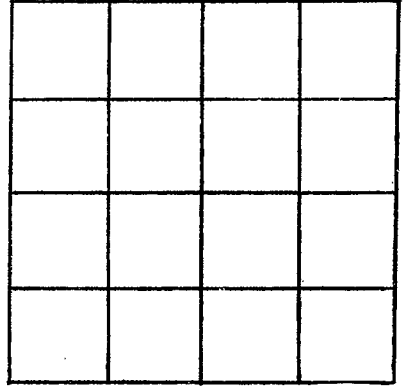

SECTION _____

Please indicate well location X.

ADDITIONAL INFORMATION

If more than one screen,
show locations of each on sketch.