

MISSISSIPPI
BOARD OF WATER COMMISSIONERS
416 North State Street
Jackson, Mississippi 39201

CODED

WATER WELL DRILLERS LOG

MARSHALL
M19
5-31-71

5-31
date well completed

1971 Dean Kent Brumby wells
firm name

Marshall
county well located

LANDOWNER:	description of formations encountered	from	to
L. S. Rushing Wall Hill, Miss (mailing address)			
WELL LOCATION:	Sand	20	60
sec. 22 T 4 N R 5 E 2.3 miles West of Holly Springs (distance) (direction) (nearest town)	clay sand	60	65 160
WELL PURPOSE: Residential (home, irrigation, municipal, industrial)			
WELL COMPLETION DATA:			
(1) diameter (inches) 4"			
(2) total depth (feet) 160 feet			
(3) static water level (feet) 25 feet below top of ground.			
(4) casing PVC, 160 feet (material) (depth)			
(size) if telescope see back.			
(5) screen 6 ft, 1.5 ft (length) (depth to top)			
4" gravel wall (size) (material)			
(6) pump 3/4 HP, 10 (yield gpm)			
(type power)			
(7) electric log (yes or no) (organization running log)			
(8) how well bottom plugged 4" cofs			
DRILLERS REMARKS:			


CODED

JUN 9 1971

MISS. Bd. of
WATER COMM.

If well telescopes please sketch and show depths.

GROUND LEVEL

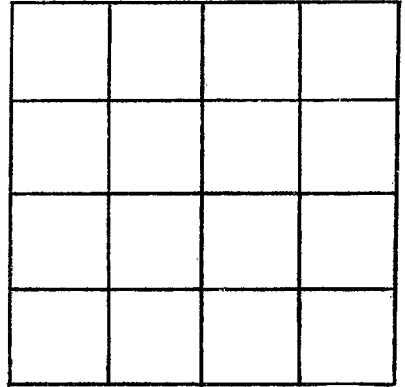

SECTION _____

Please indicate well location X.

ADDITIONAL INFORMATION

If more than one screen,
show locations of each on sketch.