

MARSHALL

M 20

1-3-62

WATER WELL DRILLERS LOG

CODED

Date: 1-3, 1962, Driller: Adams Bros. Co. Inc. County Marshall

(Name)

(1) Owner of Land: Venny Beale
(Name)

Byhalia, Rte. 3
(Address)

(2) Location: 1/4, 14 45 Sec. 45 T. 45 R.
23

23 miles of
(distance) (direction) (Nearest Town)

(3) Topography: _____
(Hilly) (Flat) (Level)

(4) Purpose of Well: _____
(Domestic Irrigation
Municipal, Industrial, Other)

| Description & Color of Materials Sand, Clay, Red Clay, Shell, etc. | Thick- ness Feet | Depth Feet |
|---|------------------------|---------------|
| <u>top soil</u> | <u>0</u> | <u>15</u> |
| <u>red sand + gravel</u> | <u>15</u> | <u>35</u> |
| <u>red sand</u> | <u>35</u> | <u>60</u> |
| <u>white sand + clay</u> | <u>60</u> | <u>80</u> |
| <u>fine white sand</u> | <u>80</u> | <u>100</u> |
| <u>coarse white sand</u> | <u>100</u> | <u>108</u> |
| <u>fine sand + clay, strigs</u> | <u>108</u> | <u>140</u> |
| <u>coarse white sand</u> | <u>140</u> | <u>160</u> |

Information upon completion of well:

(1) Diameter 4 inches.

(2) Total Depth 160 feet.

(3) Water Level 70 feet below top of ground.

(4) Cased to 146, Size _____

(5) Screen: Size 4", Length 14'


(6) Were any formations sealed against pollution?
_____ yes, _____ no.

If YES depth of formation _____

Why _____

Drillers Remarks: _____

CODED

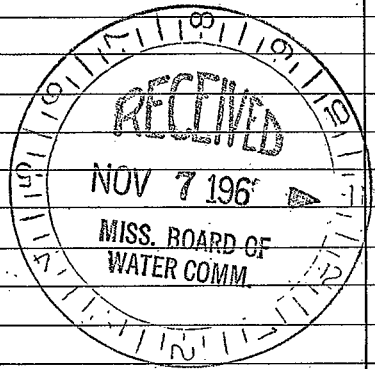

(Use Back Side)

Well No.

