

MARSHALL
M-21
7-22-71

MISSISSIPPI
 BOARD OF WATER COMMISSIONERS
 416 North State Street
 Jackson, Mississippi 39201

CODED

WATER WELL DRILLERS LOG

7-22 1971 Dearrest Springs wells Marshall
 date well completed firm name county well located

LANDOWNER:	description of formations encountered	from	to
A. R. Wilkerson	clay	0	30
Rehobothville Rt 1, Box 50 (mailing address)	sand	30	50
WELL LOCATION: sec. 27 T 4 N R 5 E	clay	50	70
22 miles west of Pecan Springs (distance) (direction) (nearest town)	sand	70	140
WELL PURPOSE: <u>Dwelling</u> (home, irrigation, municipal, industrial)			
WELL COMPLETION DATA:			
(1) diameter (inches) <u>4"</u>			
(2) total depth (feet) <u>140 feet</u>			
(3) static water level (feet) <u>100</u> below above top of ground.			
(4) casing <u>pvc</u> <u>140 feet</u> (material) (depth)			
(size) if telescope see back.			
(5) screen <u>6ft</u> <u>134 feet</u> (length) (depth to top)			
<u>4"</u> <u>gravel well</u> (size) (material)			
(6) pump <u>3/4</u> <u>10</u> (HP) (yield gpm)			
(type power)			
(7) electric log <u>clot</u> (yes or no)			
(organization running log)			
(8) how well bottom plugged <u>4" cap</u>			
DRILLERS REMARKS:			


CODED

AUG 11 1971

MISS. Bd. OF
 WATER COMMISSIONERS

If well telescopes please sketch and show depths.

GROUND LEVEL

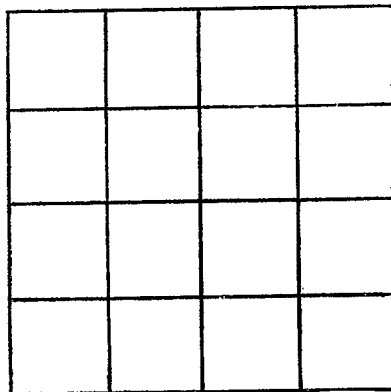

SECTION _____

Please indicate well location X.

ADDITIONAL INFORMATION

If more than one screen,
show locations of each on sketch.