

~~MARSHALL~~
~~DATE~~
 M-24
 5-17-71

MISSISSIPPI
 BOARD OF WATER COMMISSIONERS
 416 North State Street
 Jackson, Mississippi 39201

CODED
MARSHALL

WATER WELL DRILLERS LOG

5-17-1971 *Bob Smith*
 date well completed firm name county well located

LANDOWNER:	description of formations encountered	from	to
<i>m-m. Higgenbotham</i>			
<i>Chadwick, Miss</i> (mailing address)	<i>Top soil</i>	<i>0</i>	<i>10</i>
	<i>blue clay</i>	<i>10</i>	<i>50</i>
	<i>white clay</i>	<i>50</i>	<i>100</i>
	<i>white sand</i>	<i>100</i>	<i>160</i>
WELL LOCATION:			
sec. <i>24</i> T. <i>4</i> N. R. <i>5</i> E			
<i>1 mile</i> (distance) <i>NE</i> (direction) of <i>Union</i> (nearest town)			
WELL PURPOSE:			
<i>Home</i> (home, irrigation, municipal, industrial)			
WELL COMPLETION DATA:			
(1) diameter (inches) <i>4</i>			
(2) total depth (feet) <i>160</i>			
(3) static water level (feet) <i>12</i> above top of ground.			
(4) casing <i>Plastic</i> , <i>160</i> (material) (depth)			
(size) If telescope see back.			
(5) screen <i>20</i> , <i>140</i> (length) (depth to top)			
<i>4</i> , <i>Plastic</i> (size) (material)			
(6) pump <i>F2</i> , <i>10</i> (HP) (yield gpm)			
<i>Electric</i> (type power)			
(7) electric log <i>no</i> (yes or no)			
(organization running log)			
(8) how well bottom plugged <i>plugged</i>			
DRILLERS REMARKS:			


CODED

AUG 8 - 1971

MISSISSIPPI
 BOARD OF WATER COMMISSIONERS

If well telescopes please sketch and show depths.

GROUND LEVEL

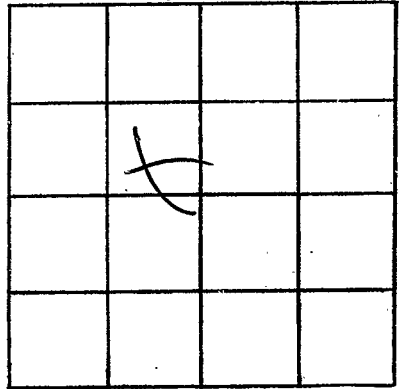

SECTION _____

Please indicate well location X.

ADDITIONAL INFORMATION

If more than one screen, show locations of each on sketch.